

15-163-03372-0000


STATE OF KANSAS
STATE CORPORATION COMMISSION

Give All Information Completely
Make Required Affidavit
Mail or Deliver Report to:
Conservation Division
State Corporation Commission
211 No. Broadway
Wichita, Kansas

WELL PLUGGING RECORD

Rooks County. Sec. 7 Twp. 10 Rge. (E) 19 (W)
Location as "NE/CNW/SW" or footage from lines SW SW SW
Lease Owner C-G Drilling Co.
Lease Name Dunlap Well No. 3
Office Address 107 Rule Building, Wichita, Kansas
Character of Well (completed as Oil, Gas or Dry Hole) Oil well
Date well completed May 24 19 50
Application for plugging filed March 15 19 57
Application for plugging approved March 15 19 57
Plugging commenced March 18 19 57
Plugging completed March 18 19 57
Reason for abandonment of well or producing formation No longer commercial

NORTH

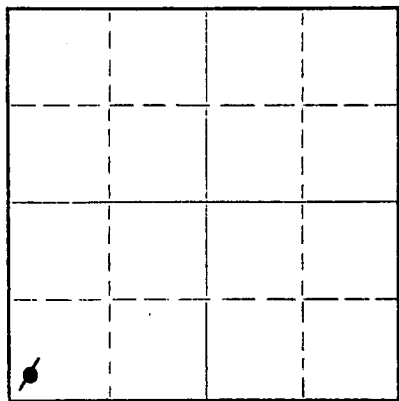

Locate well correctly on above
Section Plat

If a producing well is abandoned, date of last production March 19 56
Was permission obtained from the Conservation Division or its agents before plugging was commenced? Yes

Name of Conservation Agent who supervised plugging of this well Eldon Petty, Hays, Kansas
Producing formation Arbuckle Depth to top 3766 Bottom 3772 Total Depth of Well 3772 Feet
Show depth and thickness of all water, oil and gas formations.

OIL, GAS OR WATER RECORDS

CASING RECORD

FORMATION	CONTENT	FROM	TO	SIZE	PUT IN	PULLED OUT
				8-5/8"	257'	none
				5-1/2"	3773'	none

Describe in detail the manner in which the well was plugged, indicating where the mud fluid was placed and the method or methods used in introducing it into the hole. If cement or other plugs were used, state the character of same and depth placed, from _____ feet to _____ feet for each plug set.

Filled with mud, 40 sacks gel. Set
plug and filled to top of hole with
40 sacks of cement down 5-1/2"

(If additional description is necessary, use BACK of this sheet)

Name of Plugging Contractor C-G Drilling Co.
Address 107 Rule Building, Wichita, Kansas

STATE OF KANSAS, COUNTY OF SEDGWICK, ss.
Jay H. Galloway (employee of owner) or (owner or operator) of the above-described well, being first duly sworn on oath, says: That I have knowledge of the facts, statements, and matters herein contained and the log of the above-described well as filed and that the same are true and correct. So help me God.

(Signature) Jay H. Galloway
Jay H. Galloway 107 Rule Bldg.
(Address)

SUBSCRIBED AND SWORN TO before me this 5th day of April, 1957

My commission expires May 20, 1959
Vicky Jacobs Notary Public.

PLUGGING
SEC 7 T 10 R 19W
BOOK PAGE 2 LINE 7

4-10-57
APR 10 1957
STATE CORPORATION COMMISSION

CONTRACTOR'S WELL LOG

OPERATOR C-G Drilling Co. WELL NAME Dunlap #3
 LOCATION SW SW SW 7-10-19W RIG NO. 1
 COUNTY Rooks STATE Kansas
 COMMENCEMENT DATE May 10, 1950 COMPLETION DATE May 21, 1950
 PLUGGING COMMENCED March 15, 1957 PLUGGING COMPLETED March 18, 1957

LOG OF WELL

Elevation 2231' rotary bushing.
 All measurements taken from the top of rotary bushing.

FROM	TO	FORMATION	DEVIATION FROM VERTICAL	REMARKS:
0	255	Surface Soil		
255	850	Shale-Shells		
850	900	Sand		
900	1130	Shale		
1130	1360	Sand-Shale		
1360	1500	Shale-Shells		
1500	1645	Red Bed		
1645	1680	Anhydrite		
1680	2170	Shale-Shells		
2170	2270	Broken Lime		
2270	2380	Lime-Shale		
2380	2485	Lime		
2485	2565	Lime-Shale	0°-2500	
2565	2620	Lime-Shale		
2620	2840	Lime-Shale	0° - 2750	
2840	2930	Shale-Lime		
2930	3105	Shale-Lime	0° - 3000	
3105	3310	Shale-Lime	0° - 3250	
3310	3410	Lime-Shale		
3410	3580	Lime	0° - 3500	DST 3546-3553
3580	3675	Lime		
3675	3740	Lime-Shale		
3740	3772	Lime	0° - 3750	

CASING LEFT IN HOLE AFTER COMPLETION

Set 257' (8 jts.) 8-5/8" OD Surface Casing.
 Set 5-1/2" OD Casing at 3769-1/2'

STATE OF KANSAS }
 COUNTY OF SEDGWICK } ss.

The undersigned hereby certifies that to the best of his knowledge and belief, the above facts are true and correct.

C-G DRILLING CO.

By Jay H. Galloway
 Jay H. Galloway

Subscribed and sworn to before me this 5th day of April, 1957.

My commission expires:
 May 20, 1959

PLUGGING
 SEC. 7 T. 10 R. 19W
 PAGE 2 LINE 7

Vicky Jacobs
 Vicky Jacobs, Notary Public