


15-163-02464-0000

STATE OF KANSAS
STATE CORPORATION COMMISSION

WELL PLUGGING RECORD

Give All Information Completely
Make Required Affidavit
Mail or Deliver Report to:
Conservation Division
State Corporation Commission
800 Biting Building
Wichita, Kansas

NORTH

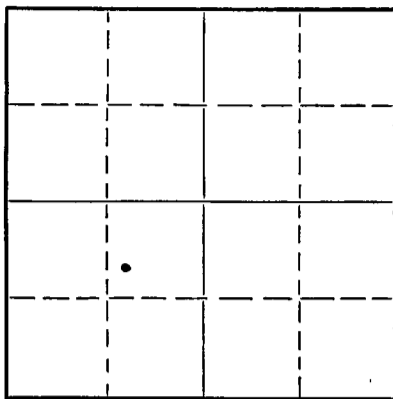

Locate well correctly on above
Section Plat

Rooks County. Sec. 9 Twp. 10s Rge. 19w (E) (W)
Location as "NE/CNW $\frac{1}{4}$ SW $\frac{1}{4}$ " or footage from lines 1650' from S line 990 from E
Lease Owner Grant Oil Co.
Lease Name Henderson Well No. I-A
Office Address 814 Central Bldg., Wichita, Kansas
Character of Well (completed as Oil, Gas or Dry Hole) Dry Hole
Date well completed 12-19-51 19
Application for plugging filed 12-19-51 19
Application for plugging approved 12-19-51 19
Plugging commenced 12-19-51 19
Plugging completed 12-19-51 19
Reason for abandonment of well or producing formation Dry

If a producing well is abandoned, date of last production 19
Was permission obtained from the Conservation Division or its agents before plugging was commenced? Yes

Name of Conservation Agent who supervised plugging of this well Elden Petty
Producing formation Depth to top Bottom Total Depth of Well 3778 Feet
Show depth and thickness of all water, oil and gas formations.

OIL, GAS OR WATER RECORDS

CASING RECORD

Formation	Content	From	To	Size	Put In	Pulled Out

Describe in detail the manner in which the well was plugged, indicating where the mud fluid was placed and the method or methods used in introducing it into the hole. If cement or other plugs were used, state the character of same and depth placed, from 155 feet feet to 40 feet feet for each plug set.
Filled hole with mud to 155 feet, set plug with 1/2 sack of hulls and 15 sacks of cement. Filled hole with mud 40 feet from surface. Set plug. 1/2 sack of hulls on top of plug. Mixed and displaced 10 sacks of cement.

12-27-51

(If additional description is necessary, use BACK of this sheet)

Correspondence regarding this well should be addressed to Paul Pfeifer
Address 2536 Mc Bride, Great Bend, Ks.

STATE OF Kansas, COUNTY OF Barton, ss.
I, Paul Pfeifer (employee of owner) or (owner or operator) of the above-described well, being first duly sworn on oath, says: That I have knowledge of the facts, statements, and matters herein contained and the log of the above-described well as filed and that the same are true and correct. So help me God

(Signature) Paul Pfeifer

SUBSCRIBED AND SWORN to before me this 20th day of December 1951

9-4-54

(Address) Notary Public

My commission expires

23-5091-s 8-50-10M

PLUGGING
FILE NO. 9710 R90
BOOK 133

15-163-02464-0000

HENDERSON NO. 4


SW/4 NE/4 SW/4 Sec. 9-10S-19W, Rooks County, Kansas

Rigging up Rotary Tools 12-6-51
Tearing down Rotary Tools 12-19-51

Run 161' 8 5/8" surface pipe. Cemented
with 120 sacks cement.

<u>FORMATION</u>	<u>FROM</u>	<u>TO</u>
Sand, clay and shale	0	40
Shale, sand and shells	40	1310
Shale and redbed	1310	1565
Shale and shells	1565	2114
Shale and shell lime streaks	2114	2365
Shale and shells	2365	2575
Lime streaks	2575	2635
Lime and shells	2635	3095
Lime and shale	3095	3205
Sandy shale and lime	3205	3255
Lime	3255	3447
Lime and shale	3447	3537
Lime	3537	3572
Lime and shale	3572	3640
Broken lime and shale	3640	3695
Shale and lime	3695	3752
Chirt lime, Conglomerate	3752	3778 Total Depth

I, W. A. Grant, hereby certify that the above Log is true and correct,
to the best of my knowledge and belief.

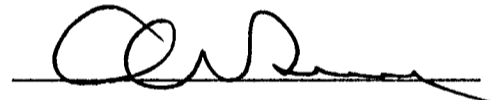

Subscribed and sworn to before me this 26th day of December, 1951.


Notary Public

My commission expires: March 22, 1952

