

15-163-20757-0000

STATE OF KANSAS
STATE CORPORATION COMMISSION

WELL PLUGGING RECORD

Give All Information Completely
Make Required Affidavit
Mail or Deliver Report to:
Conservation Division
State Corporation Commission
212 North Market, Insurance Bldg.
Wichita, Kansas

Rooks

County. Sec. 9 Twp. 10S Rge. 19W (E) (W)

Location as "NE/CNW/SW" or footage from lines C E/2 NE NW

Lease Owner John P. Jennings Oil Co.

Lease Name BALDWIN

Well No. 5

Office Address 200 E. First, Suite 309, Wichita, KS 67202

Character of Well (completed as Oil, Gas or Dry Hole) Dry Hole

Date well completed 11-30-77 19

Application for plugging filed Yes 19

Application for plugging approved 19


Plugging commenced 19

Plugging completed 10:00 A.M., 11-30-77 19

Reason for abandonment of well or producing formation

If a producing well is abandoned, date of last production 19

Was permission obtained from the Conservation Division or its agents before plugging was commenced? Yes

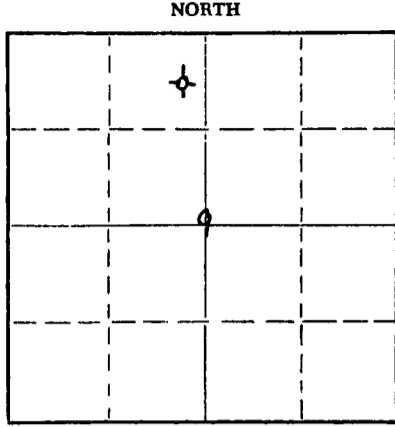

Locate well correctly on above Section Plat

Name of Conservation Agent who supervised plugging of this well Leo Massey

Producing formation Depth to top Bottom Total Depth of Well Feet

Show depth and thickness of all water, oil and gas formations.

OIL, GAS OR WATER RECORDS

CASING RECORD

FORMATION	CONTENT	FROM	TO	SIZE	PUT IN	PULLED OUT

Describe in detail the manner in which the well was plugged, indicating where the mud fluid was placed and the method or methods used in introducing it into the hole. If cement or other plugs were used, state the character of same and depth placed, from feet to feet for each plug set.

#1	720'	70	sx.
#2	185'	20	sx.
#3	40'	10	sx.

RECEIVED
STATE CORPORATION COMMISSION
12-6-77
DEC 06 1977

CONSERVATION DIVISION
Wichita, Kansas

Name of Plugging Contractor John O. Farmer, Inc. (If additional description is necessary, use BACK of this sheet)

Address Box 352, Russell, Kansas 67665

STATE OF KANSAS COUNTY OF RUSSELL, ss.
John O. Farmer, III (employee of owner) or (owner or operator) of the above-described

well, being first duly sworn on oath, says: That I have knowledge of the facts, statements, and matters herein contained and the log of the above-described well as filed and that the same are true and correct. So help me God.

(Signature) John O. Farmer III
Box 352, Russell, Kansas 67665 (Address)

SUBSCRIBED AND SWORN TO before me this 30th day of November, 1977

My commission expires February 15, 1979

Helen Carlson
Notary Public.

Your File Copy

15-163-20757-0000

KANSAS DRILLERS LOG

S. 9 T. 10S R. 19W^E_W

API No. 15 _____
County _____ Number _____


Loc. C E/2 NE NW

County _____ Rooks

Operator
John P. Jennings Oil Co.

640 Acres
N

Address
200 E. First, Suite 309, Wichita, KS 67202

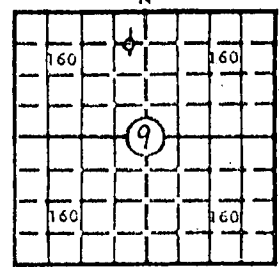

Well No. 5 Lease Name BALDWIN

Footage Location
660 feet from (N) XX line 330 feet from (E) XX line

Locate well correctly
Elev.: Gr. 2210

Principal Contractor
John O. Farmer, Inc. Geologist
Richard E. Roby

Spud Date 11-21-77 Total Depth 3780 P.B.T.D.

Date Completed 11-30-77 Oil Purchaser
None -- D & A

DF 2213 KB 2215

CASING RECORD

Report of all strings set — surface, intermediate, production, etc.

Purpose of string	Size hole drilled	Size casing set (in O.D.)	Weight lbs/ft.	Setting depth	Type cement	Sacks	Type and percent additives
Surface	12 1/4	8-5/8	26	202	Common	140	

LINER RECORD

PERFORATION RECORD

Top, ft.	Bottom, ft.	Sacks cement	Shots per ft.	Size & type	Depth interval

TUBING RECORD

Size	Setting depth	Packer set at

ACID, FRACTURE, SHOT, CEMENT SQUEEZE RECORD

Amount and kind of material used	Depth interval treated

RECEIVED
STATE CORPORATION COMMISSION

JAN 26 1978

CONSERVATION DIVISION
Wichita, Kansas

INITIAL PRODUCTION

Date of first production		Producing method (flowing, pumping, gas lift, etc.)			
RATE OF PRODUCTION PER 24 HOURS	Oil	Gas	Water	Gas-oil ratio	
	bbis.	MCF	bbis.	CFPB	
Disposition of gas (vented, used on lease or sold)			Producing interval(s)		

INSTRUCTIONS: As provided in KCC Rule 82-2-125, within 90 days after completion of a well, one completed copy of this Drillers Log shall be transmitted to the State Geological Survey of Kansas, 4150 Monroe Street, Wichita, Kansas 67209. Copies of this form are available from the Conservation Division, State Corporation Commission, 3830 So. Meridian (P.O. Box 17027), Wichita, Kansas 66217. Phone AC 316-522-2206. If confidential custody is desired, please note Rule 82-2-125. Drillers Logs will be on open file in the Oil and Gas Division, State Geological Survey of Kansas, Lawrence, Kansas 66044.

15-163-20757-0000

Operator - John P. Jennings Oil Co. DESIGNATE TYPE OF COMP.: OIL, GAS, DRY HOLE, SWDW, ETC.:

Well No. 5 Lease Name BALDWIN Dry Hole

S 9 T10S R 19 W E W

WELL LOG

Show all important zones of porosity and contents thereof; cored intervals, and all drill-stem tests, including depth interval tested, cushion used, time tool open, flowing and shut-in pressures, and recoveries.

SHOW GEOLOGICAL MARKERS, LOGS RUN, OR OTHER DESCRIPTIVE INFORMATION.

FORMATION DESCRIPTION, CONTENTS, ETC.	TOP	BOTTOM	NAME	DEPTH
			Sample Tops:	
Sand & Shale	0	202	Anhydrite	1598 +617
Shale	202	780	Topeka	3202 -987
Shale & Sand	780	1075	Heebner Shale	3413 -1198
Sand	1075	1275	Lansing-K.C.	3451 -1236
Shale & Shells	1275	1320	Base Kansas City	3657 -1442
Shale, Shells & Sand	1320	1598	Penn. Conglomerate	3715 -1500
Anhydrite	1598	1634	Arbuckle	3774 -1559
Shale & Shells	1634	2050	Total Depth	3780 -1565
Shale & Lime	2050	2535		
Lime & Shale	2535	2835		
Shale & Lime	2835	3275		
Lime & Shale	3275	3530		
Lime	3530	3678		
Lime & Shale	3678	3715		
Chert & Congl.	3715	3755		
Cong. Chert	3755	3780		
DST# 1 3430' - 3507'				
5' mud, open 30, shut 30, open 30, shut 30				
all pressures 20#				
DST# 2 3512' - 3545'				
15' mud open 30, shut 30, open 30, shut 30				
IFP 20, FFP 20				
ISP 450, FSI 440				
DST# 3 3600' - 3633'				
recovered 15' mud				
open 30, shut 30, open 30, shut 30				
ISP 30 30				
FFP 30 30				
ISP 438				
FFP 438				

RECEIVED
STATE CORPORATION COMMISSION

JAN 26 1978

CONS. DIVISION
Wichita, Kansas

USE ADDITIONAL SHEETS, IF NECESSARY, TO COMPLETE WELL RECORD.

Date Received 12-6-77	Signature <i>John P. Jennings</i> John P. Jennings Operator
	Title 12-6-77 Date