


WELL PLUGGING RECORD

Give All Information Completely  
Make Required Affidavit  
Mail or Deliver Report to:  
Conservation Division  
State Corporation Commission  
212 No. Market  
Wichita, Kansas

NORTH

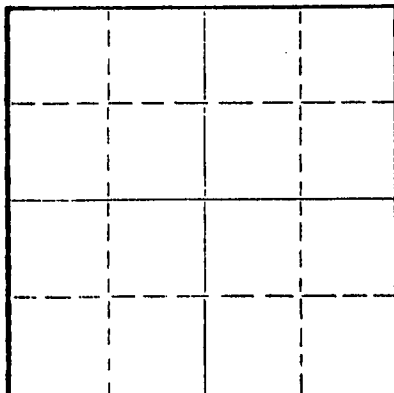

Locate well correctly on above  
Section Plat

Russell County, Sec. 34 Twp. 12 Rge. 15 (E) W (W)  
Location as "NE/CNW%SW%" or footage from lines NE SW SE  
Lease Owner Shields Oil Producers, Inc.  
Lease Name Davis "A" Well No. 1  
Office Address Russell, Kansas  
Character of Well (completed as Oil, Gas or Dry Hole) Dry hole  
Date well completed January 17, 19 69  
Application for plugging filed January 17, 19 69  
Application for plugging approved January 17, 19 69  
Plugging commenced January 17, 19 69  
Plugging completed January 17, 19 69  
Reason for abandonment of well or producing formation Dry hole

If a producing well is abandoned, date of last production 19  
Was permission obtained from the Conservation Division or its agents before plugging was commenced? Yes

Name of Conservation Agent who supervised plugging of this well Don Truan  
Producing formation Depth to top Bottom Total Depth of Well 2,935' Feet  
Show depth and thickness of all water, oil and gas formations.

OIL, GAS OR WATER RECORDS

CASING RECORD

FORMATION	CONTENT	FROM	TO	SIZE	PUT IN	PULLED OUT
				8 5/8"	250'	Cmtd. w/175 sax

Describe in detail the manner in which the well was plugged, indicating where the mud fluid was placed and the method or methods used in introducing it into the hole. If cement or other plugs were used, state the character of same and depth placed, from feet to feet for each plug set.

Fill hole w/ heavy mud to 500'  
Set bridge plug @ 500'  
Spotted 50 sax cement on plug thru 4 1/2" drill pipe  
Fill hole w/ heavy mud to 240'  
Set bridge plug @ 240'  
Spotted 25 sax cement on plug thru 4 1/2" drill pipe  
Fill hole w/ heavy mud to 40'  
Set bridge plug @ 40' w/ 1/2 sax hulls on plug  
Dump 10 sax cement on plug to cellar

RECEIVED  
STATE CORPORATION COMMISSION  
2-19-1969  
FEB 19 1969  
CONSERVATION DIVISION  
Wichita, Kansas

(If additional description is necessary, use BACK of this sheet)

Name of Plugging Contractor Shields Drilling Co., Inc.  
Address Shields Bldg., Russell, Kansas

STATE OF Kansas, COUNTY OF Russell  
R. J. Shields contractor, ss.  
(employee of owner) or (owner or operator) of the above-described well, being first duly sworn on oath, says: That I have knowledge of the facts, statements, and matters herein contained and the log of the above-described well as filed and that the same are true and correct. So help me God.

(Signature) R. J. Shields  
Shields Bldg., Russell, Kansas  
(Address)

SUBSCRIBED AND SWORN TO before me this 18th day of February, 1969

My commission expires May 26, 1971  
Ruth Phillips Notary Public.




# Shields

15-167-20279-00-00 *Russell, Kansas*

## WELL LOG

**Operator:** Shields Oil Producers, Inc.  
**Well:** Davis "A" #1  
**Commenced:** January 12, 1969  
**Completed:** January 17, 1969  
**Contractor:** Shields Drilling Co., Inc.

**Well Description:** NE SW SE  
 Sec. 34-12S-15W  
 Russell County, Kansas

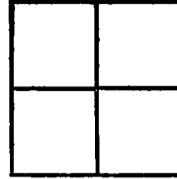

CASING RECORD		
Size	Run	Pulled
8 5/8"	250'	Cmtd.w/ 175 sax

**Elevation:**  
**Treatment:**  
**Production:** D & A  
**Tops:**

..... Figures Indicate Bottom of Formations .....

Rock and shale	75'	
Shale and sand	255'	
Shale, pyrite and sand	500'	
Redbed	863'	
Anhydrite	899'	
Shale and shells	1,425'	
Lime and shale	1,825'	
Lime	2,075'	
Lime and shale	2,710'	
Lime	2,935'	RTD

RECEIVED  
 STATE CORPORATION COMMISSION  
 2-19-1969  
 FEB 19 1969  
 CONSERVATION DIVISION  
 Wichita, Kansas

Notes