

WELL PLUGGING RECORD

Give All Information Completely
Make Required Affidavit
Mail or Deliver Report to:
Conservation Division
State Corporation Commission
800 Bittling Building
Wichita, Kansas

Ellis County. Sec. 5 Twp. 12 Rge. 16 (E) W (W)

Location as "NE/CNW&SW¼" or footage from lines SE SE NW

Lease Owner Nadel and Gussman

Lease Name Chrisler Well No. 1

Office Address Box 309, Tulsa, Oklahoma

Character of Well (completed as Oil, Gas or Dry Hole) Dry

Date well completed 3-2 1954

Application for plugging filed 3-2 1954

Application for plugging approved 3-2 1954


Plugging commenced 3-2 1954

Plugging completed 3-2 1954

Reason for abandonment of well or producing formation Dry

If a producing well is abandoned, date of last production 19

Was permission obtained from the Conservation Division or its agents before plugging was commenced? Yes

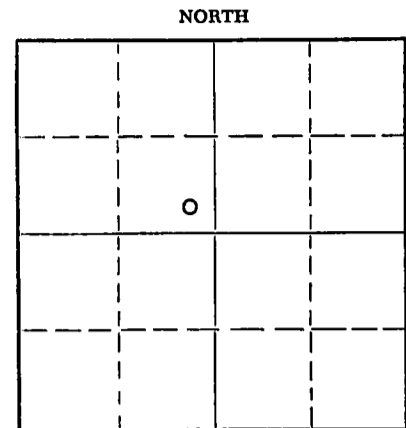

Locate well correctly on above Section Plat

Name of Conservation Agent who supervised plugging of this well Elden Petty

Producing formation _____ Depth to top _____ Bottom _____ Total Depth of Well 3450 Feet

Show depth and thickness of all water, oil and gas formations.

OIL, GAS OR WATER RECORDS

CASING RECORD

FORMATION	CONTENT	FROM	TO	SIZE	PUT IN	PULLED OUT
				8-5/8"	209	0

Describe in detail the manner in which the well was plugged, indicating where the mud fluid was placed and the method or methods used in introducing it into the hole. If cement or other plugs were used, state the character of same and depth placed, from _____ feet to _____ feet for each plug set.

Filled hole with heavy mud from 3450 to 180'

Set plug and cemented with 15 sacks cement

Set second plug @ 35' and cemented with 10 sacks cement.

3-11-1954

(If additional description is necessary, use BACK of this sheet)

Name of Plugging Contractor Reserve Drilling Company, Inc.

Address 703 Union National Bank Bldg. Wichita 2, Kansas

STATE OF KANSAS, COUNTY OF SEDGWICK, ss.

L. C. Hay (employee of owner) ~~XXXXXXXXXXXX~~ of the above-described

well, being first duly sworn on oath, says: That I have knowledge of the facts, statements, and matters herein contained and the log of the above-described well as filed and that the same are true and correct. So help me God.


(Signature) R. C. Hay

(Address) March 1954

SUBSCRIBED AND SWORN TO before me this 8th day of March 1954

My commission expires Nov. 3, 1956

Notary Public.

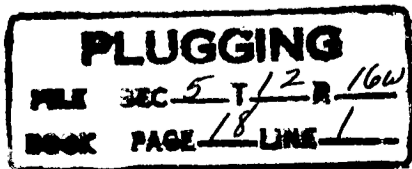

15-051-00777-00-00

NADEL AND GUSSMAN

CHRISLER No. 1

SE SE NW 5-12-16W
Ellis County, Kansas

Comm: 2-17-54
Comp: 3- 2-54

Casing: 8-5/8" 209' w/135 sax

Formations

Depth

Shale	460
Sand	490
Shale	750
Shale and shells	810
Shale	955
Shale and lime	1015
Anhydrite	1050
Lime and shale	1210
Shale	1390
Shale and red bed	1590
Shale and lime	2880
Lime	2938
Lime and shale	3190
Lime	3281
Lime and shale	3326
Shale	3373
Lime and shale	3401
Conglomerate	3450

Geological Tops

Neebner Shale	3036
Toronto	3057
Lansing-Kansas City	3082
Base Kansas City	3280
Cherty Conglomerate	3401

STATE OF KANSAS)
) SS:
 COUNTY OF SEDGWICK)

L. C. Hay, of lawful age, deposes and states that the above depths and formations are correct as shown by the daily drilling log of the Chrisler No. 1 Well in the SE SE NW 5-12-16W, Ellis County, Kansas.

L. C. Hay

Subscribed and sworn to before me this 8th day of March, 1954.

W. B. Babb
Notary Public

My commission expires Nov. 3, 1956 ³-11-1954

PLUGGING
 FILE SEC 5 T 12 R 16W
 BOOK PAGE 18 LINE 1