


STATE OF KANSAS
STATE CORPORATION COMMISSION

15-051-00388-00-00
WELL PLUGGING RECORD

Give All Information Completely
Make Required Affidavit
Mail or Deliver Report to:
Conservation Division
State Corporation Commission
212 North Market, Insurance Bldg.
Wichita, Kansas

Ellis County, Sec. 6 Twp. 12S Rge. 16 (E) W (W)

NORTH

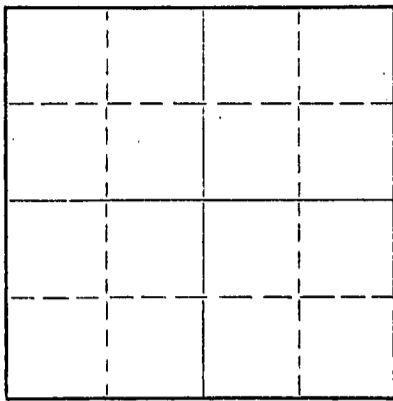

Locate well correctly on above
Section Plat

Location as "NE/CNW%SW%" or footage from lines C SE NE
Lease Owner Davis Bros. - Transit Corporation
Lease Name Chrisler "O" Well No. 1
Office Address 1516 Liberty Bank Bldg., Okla. City, Okla.
Character of Well (completed as Oil, Gas or Dry Hole) D & A
Date well completed May 7, 19 59
Application for plugging filed May 7, 19 59
Application for plugging approved May 7, 19 59
Plugging commenced May 7, 19 59
Plugging completed May 7, 19 59
Reason for abandonment of well or producing formation No production

If a producing well is abandoned, date of last production 19
Was permission obtained from the Conservation Division or its agents before plugging was commenced? Yes

Name of Conservation Agent who supervised plugging of this well Eldon Petty-Box 326-Hays, Kansas
Producing formation _____ Depth to top _____ Bottom _____ Total Depth of Well _____ Feet
Show depth and thickness of all water, oil and gas formations.

OIL, GAS OR WATER RECORDS

CASING RECORD

FORMATION	CONTENT	FROM	TO	SIZE	PUT IN	PULLED OUT
				8 5/8"	173'	None

Describe in detail the manner in which the well was plugged, indicating where the mud fluid was placed and the method or methods used in introducing it into the hole. If cement or other plugs were used, state the character of same and depth placed, from _____ feet to _____ feet for each plug set.

Filled hole with heavy drilling mud to 400'; set plug, cemented with 20 sacks cement
Filled hole with heavy drilling mud to 150'; set plug, cemented with 15 sacks cement
Filled hole with heavy drilling mud to 40'; set plug, cemented with 2 sacks dry cement
and 8 sacks mixed cement to bottom of cellar

RECEIVED
STATE CORPORATION COMMISSION
AUG 11 1959
CONSERVATION DIVISION

(If additional description is necessary, use BACK of this sheet)
Name of Plugging Contractor Transit Corporation
Address 1516 Liberty Bank Building, Oklahoma City, Oklahoma

STATE OF Oklahoma, COUNTY OF Oklahoma, ss.
Paul E. Gathers (employee of owner) or (owner or operator) of the above-described well, being first duly sworn on oath, says: That I have knowledge of the facts, statements, and matters herein contained and the log of the above-described well as filed and that the same are true and correct. So help me God.

(Signature) Paul E. Gathers

(Address) _____

SUBSCRIBED AND SWORN to before me this 10th day of June, 19 59

Mildred Seom
Notary Public.

My commission expires May 17, 1962

PLUGGING
FILE SEC. 6 T. 12 R. 16W
BOOK PAGE 54 LINE 40

15-051-00388-00-00

DRILLER'S WELL LOG

Davis Bros.-Transit Corporation - Chrisler "O" # 1 well located in
C SE NE Section 6-12S-16W,
Ellis County, Kansas

RECORDED
STATE CORPORATION
8-11-1959
AUG 11 1959
CONSERVATION DIVISION
Wichita, Kansas

Commenced: April 25, 1959
Completed: May 7, 1959
Elevation: 1921' KB

Casing 8 5/8" @ 173'
Cemented w/125 sacks

<u>Formation</u>	<u>From</u>	<u>To</u>
Shale	0	65
Clay	65	130
Shale and pyrite	130	140
Shale	140	170
Shale and shells	170	250
Sand	250	300
Shale	300	460
Sand	460	740
Shale and shells	740	1081
Anhydrite	1091	1128
Shale	1128	1706
Lime and shale	1706	2015
Lime	2015	2125
Lime and shale	2125	2560
Shale w/lime streaks	2560	2685
Lime and shale	2685	2760
Shale and lime	2760	2860
Lime and shale	2860	2985
Lime	2985	3460
Conglomerate and chert	3460	3508
Lime	3508	3555 TD

Summary of Formation

Topeka	2858'
Heebner	3099'
Toronto	3121'
Douglas	3134'
Lansing	3146'
Base of K.C.	3366'
Conglomerate	3430'
Arbuckle	3508'

I hereby certify the foregoing to be a true and accurate Driller's Log of the formation encountered in the above well.

Subscribed and sworn to before me
this 10th. day of June, 1959.

TRANSIT CORPORATION

BY Paul E. Gathers

My Commission expires May 17, 1962.

Mildred Snow
Notary Public

PLUGGING
FILE SEC. 6 T. 12 R. 16W
BOOK PAGE 54 LINE 40