

WELL PLUGGING RECORD

FORMATION PLUGGING RECORD

Strike out upper line when reporting plugging of formations.

STATE OF KANSAS STATE CORPORATION COMMISSION

Give All Information Completely Make Required Affidavit Mail or Deliver Report to:


Conservation Division State Corporation Commission 800 Bittling Building Wichita, Kansas

Books

County. Sec. 34 Twp. 20 Rge. (E) 19 (W)

Location as "NE 1/4 NW 1/4 SW 1/4" or footage from lines SE-N-E-N. Lease Owner. Simpson Oil Company et al. Lease Name. Bair Well No. 1 Office Address. 715 First Nat'l Bldg., Wichita, Kansas Character of Well (Completed as Oil, Gas or Dry Hole) DRY Date, well completed June 27 1939 Application for plugging filed June 13 1939 Application for plugging approved June 15 1939 Plugging Commenced June 27 1939 Plugging Completed June 28 1939 Reason for abandonment of well or producing formation Dry Hole

NORTH

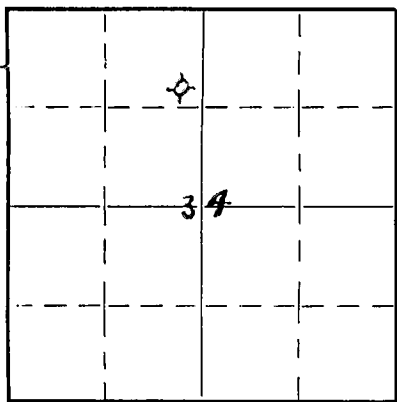

Locate well correctly on above Section Plat

If a producing well is abandoned, date of last production --- 1939 Was permission obtained from the Conservation Division or its agents before plugging was commenced? Yes

Name of Conservation Agent who supervised plugging of this well T. A. Alexander Producing formation --- Depth to top --- Bottom 3707 Total Depth of Well 3707 Feet.

Show depth and thickness of all water, oil and gas formations.

OIL, GAS OR WATER RECORDS

CASING RECORD

Table with 7 columns: Formation, Content, From, To, Size, Put In, Pulled Out. Row 1: S. Line, Hole Full water, 3693, 3707, 7" S. P., 3693, 3800.

Describe in detail the manner in which the well was plugged, indicating where the mud fluid was placed and the method or methods used in introducing it into the hole. If cement or other plugs were used, state the character of same and depth placed, from 350' feet to 350' feet for each plug set. Jetted full of rotary mud from 3707' to 350' cement plug from 350' to 350' filled with rotary mud to 10 feet of top, cement cap in top 10' thick.

PLUGGING FILE SEC 34-10-2190 BOOK PAGE 66 LINE 22

JUL 3 1939 7-3-39

(If additional description is necessary, use BACK of this sheet)

Correspondence regarding this well should be addressed to Simpson Oil Company, 715 First Nat'l Bldg., Wichita, Kansas

STATE OF Kansas, COUNTY OF Sedgewick, ss. Sam Payne, Jr. (employee of owner) or (owner or operator) of the above-described well,

being first duly sworn on oath, says: That I have knowledge of the facts, statements, and matters herein contained and the log of the above-described well as filed and that the same are true and correct. So help me God.

(Signature) Sam Payne, Jr.

715 First Nat'l Bldg., Wichita, Kansas (Address)

SUBSCRIBED AND SWORN to before me this 30th day of June, 1939

My commission expires August 10, 1940 17-6058 10-38-5M Notary Public.

BAIR WELL NO. 1

Simpson Oil Company et al.
 Contractor: Simpson & Noble, Inc.
 Total Depth: 3707'
 Elevation: 2163'
 Casing: 16" O. D. 142' 5"
 7" 3693'

SE-NE-NW 34-10S-19W, Rooks County, Kansas
 Commenced: 5-13-39; Completed: 6-15-39
 Rotary & Completed with Cable Tools
 Dry and Abandoned

Log

(Figures Indicate Bottom of Formations)

Surface rock	20
Shale	175
Shale, shells	545
Sand	825
Shale & shells	937
Sand, white	1230
Sand, red	1260
Shale, red & blue	1414
Shale, shells, iron	1514
Anhydrite	1540
Shale & shells	1905
Salt & shale, broken	2023
Broken lime	2595
Sandy lime & water	2615
Lime broken	2720
Broken lime & shale	2863
Lime & shale	2934
Broken lime & shale	3130
Lime broken	3238
Lime	3365
Broken lime & shale	3393
Lime (K. C.)	3395
Lime	3562
Broken lime & shells	3606
Shale & chert	3650
Chert & red shale	3670
Shale	3693
Lime (Top Sil. 3691)	3707
S. O.	
Total Depth	

3691-3705
 FILE NO. 34, 10 3707
 BOOK PAGE 46 LINE 2-2

Sample Tops

Anhydrite	1497
Ft. Riley	2270
K. C. (Lansing)	3393
Aruckle (Siliceous)	3693

STATE OF KANSAS)
) ss
 COUNTY OF SEDGWICK)

_____ of lawful age, being first duly sworn does hereby
 state and declare that the above noted formations is a true and correct drilling
 log of the above described well.

_____ and sworn to before me this _____ day of June, 1939.

 Notary Public

My commission expires March 30, 1940.

ERNEST E. BLINCOE, CHAIRMAN
HOMER HOCH
E. R. SLOAN
COMMISSIONERS

PHONES 2-0488—L. D. 78

15-163-30337-0000

E. G. DAHLGREN, DIRECTOR, WICHITA

LEO R. PRICE, SECRETARY
INNIS D. HARRIS, ATTORNEY




801 HARRISON
TOPEKA, KANSAS

STATE OF KANSAS
STATE CORPORATION COMMISSION
CONSERVATION DIVISION
800 BITTING BUILDING
WICHITA, KANSAS

July 3, 1939

IN REPLY PLEASE
REFER TO THIS
SUBJECT

Simpson Oil Company
713 First Nat'l. Bank Bldg.
Wichita, Kansas

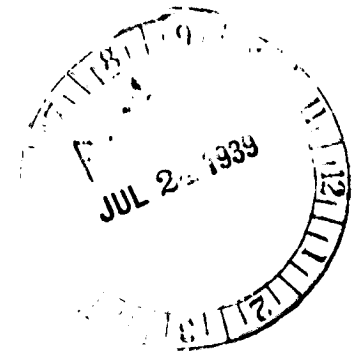

IN ACCOUNT WITH Conservation Division, State Corporation Commission
Wichita, Kansas

WE Charge YOU

Plugging Assessment.....\$ 25.00

Well No. ¹ Bair
Farm
Description SE 1/4 N. 34-10-19.
County ^{Rooks} 66-22
File

pd 7/24/39 Ha,

The assessment for the plugging of all wells is one cent per foot, with a maximum of \$25.00 and a minimum of \$5.00.

This assessment will be past due July 29, 1939.

EMH:ha

PLEASE RETURN ONE COPY WITH REMITTANCE.

