


WELL PLUGGING RECORD

Give All Information Completely
Make Required Affidavit
Mail or Deliver Report to:
Conservation Division
State Corporation Commission
800 Bittling Building
Wichita, Kansas

OR
FORMATION PLUGGING RECORD

Strike out upper line
when reporting plugging
off formations.

Rooks County. Sec. 34 Twp. 10 Rge. (E) 19 (W)
Location as "NE $\frac{1}{4}$ NW $\frac{1}{4}$ SW $\frac{1}{4}$ " or footage from lines. NE $\frac{1}{4}$ NE $\frac{1}{4}$ SE $\frac{1}{4}$
Lease Owner J. A. Allison et al.
Lease Name Aksamit Well No. 1
Office Address 715 Brown Bldg. Wichita, Kansas
Character of Well (completed as Oil, Gas or Dry Hole) Dry Hole
Date well completed 11-9 1947
Application for plugging filed 19
Application for plugging approved 19
Plugging commenced 19
Plugging completed 11-27 1947
Reason for abandonment of well or producing formation Dry Hole

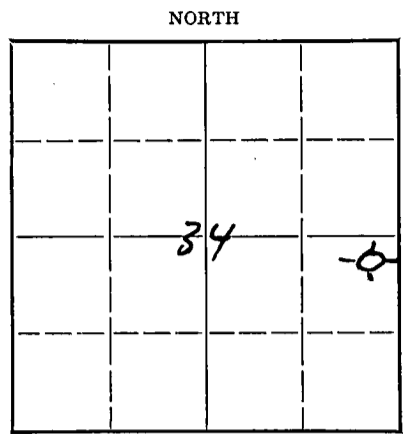

Locate well correctly on above
Section Plat

If a producing well is abandoned, date of last production 19
Was permission obtained from the Conservation Division or its agents before plugging was commenced? Yes
Name of Conservation Agent who supervised plugging of this well C. D. Stough
Producing formation None Depth to top Bottom Total Depth of Well 3683 Feet
Show depth and thickness of all water, oil and gas formations.

OIL, GAS OR WATER RECORDS CASING RECORD

Formation	Content	From	To	Size	Put In	Pulled Out
Topeka - 941	Water	3224	38			
Kansas City - 1200	Water	3356	60		3390	2927.10

Describe in detail the manner in which the well was plugged, indicating where the mud fluid was placed and the method or methods used in introducing it into the hold. If cement or other plugs were used, state the character of same and depth placed, from feet to feet for each plug set.

Total Depth was 3683' 5 $\frac{1}{2}$ inch pipe was set at 3390. The cement was not drilled out of the bottom joint leaving cement plug from 3367 - 90. Filled with Rock to 3352 above perforations dumped 5 sacks cement mudded hole to 200 feet Dumped 5 sacks cement Mudded to 30' Dumped 10 sacks cement. Well completed

DEC 16 1947
12-16-47

(If additional description is necessary, use BACK of this sheet)

Correspondence regarding this well should be addressed to J. A. Allison
Address 715 Brown Bldg
Wichita, Kansas

STATE OF Kansas, COUNTY OF Sedgwick, ss.
Owner (employee of owner) or (owner or operator) of the above-described well,
being first duly sworn on oath, says: That I have knowledge of the facts, statements, and matters herein contained and the log of the above-described well as filed and that the same are true and correct. So help me God.

(Signature) J A Allison
715 Brown Bldg Wichita, Kansas
(Address)

SUBSCRIBED AND SWORN to before me this 15th day of December, 1947

My commission expires January 27, 1951
Notary Public.

PLUGGING
FILE SEC 34 T 10 R 19W
BOOK PAGE 2 LINE 5

LEASE: Aksamit #1
OWNER: J.A. Allison et al
CONTRACTOR: Earl F. Wakefield
COMM: 10-15-47 COMP: 11-3-47

LOCATION: NE NE SE 34-10-19
COUNTY : Rooks County, Kansas
CASING : 8 5/8 set @ 165'
5 1/2 set @ 3393'

Clay Sand & Shale	130	Shale	2906
Blue shale	165	Shale & Lime Streaks	2942
Shale	230	Lime	2956
Shale Gyp Shells	485	Shale	2968
Shale & Sand	780	Lime	2982
Shale & Iron	911	Shale & Lime Shells	3002
Sand	1115	Shale & Lime	3024
Shale	1220	Lime	3084
Red bed & Shale	1410	Soft Lime	3094
Anhydrite	1453	Lime	3335
Shale	1530	Cherty Lime	3345
Shale & Shells	1750	Lime	3402
Shale & Salt Strks.	1788	Soft Lime	3407
Shale & Salt	1915	Lime	3430
Shale	1935	Lime & Chert	3456
Lime	1985	Lime	3574
Lime & Strks. of Shale	2015	Chert	3583
Lime & Shale	2100	Conglomerate Cherty	3603
Broken Lime	2140	Chert & Conglomerate	3649
Lime & Shale	2180	Arbuckle	3683
Lime	2250	Total Depth	3683
Lime	2280		
Lime & Shale	2297		
Lime & Shale Breaks	2367	Drill Stem Test come out of	
Lime	2402	hole 135' water.	
Lime & Shale Broken	2520		
Shale	2550		
Lime	2573		
Lime & Shale	2675		
Lime	2725		
Shale	2763		
Sticky shale	2800		
Lime	2820		
Shale & Shells	2855		

STATE OF KANSAS }
COUNTY OF SEDGWICK } SS

I hereby certify that the above is a true and correct copy of the log of the Aksamit #1 well located in the NE SE SE 34-10-19, Rooks County, Kansas

Earl F. Wakefield

Subscribed and sworn to before me this 7th day of November 1947.

Jeanne Lafney

My Commission Expires: 12-23-50

PLUGGING
FILE SEC 34 T 10 R 190
BOOK PAGE 2 LINE 5

15-163-02369-0000



STATE OF KANSAS
STATE CORPORATION COMMISSION
CONSERVATION DIVISION
800 BITTING BUILDING
WICHITA, KANSAS

December 1, 1947

IN REPLY PLEASE
REFER TO THIS
SUBJECT

Mr. J. A. Allison
912 Brown Bldg.
Wichita, Kas.

Dear Sir:

IN ACCOUNT WITH Conservation Division, State Corporation Commission
Wichita, Kansas

WE Charge YOU

Plugging Assessment.....\$ 25.00

Well No. 1
Farm Aksanit
Description N. H. 34-10-1.1w
County
File: books
2-5

The assessment for the plugging of all wells in the State of Kansas is one cent per foot, with a maximum of \$25.00 and a minimum of \$5.00.

This assessment ~~will be~~ past due January 1, 1947

PLEASE RETURN ONE COPY WITH REMITTANCE

NOTE: We also need a written application, a well log and a well plugging record on this well to complete our file.

94
Paid
12-17-47
[Signature]