

WELL PLUGGING RECORD


Give All Information Completely  
Make Required Affidavit  
Mail or Deliver Report to:  
Conservation Division  
State Corporation Commission  
800 Bittling Building  
Wichita, Kansas

OR

FORMATION PLUGGING RECORD

Strike out upper line  
when reporting plug-  
ging off formations.

NORTH

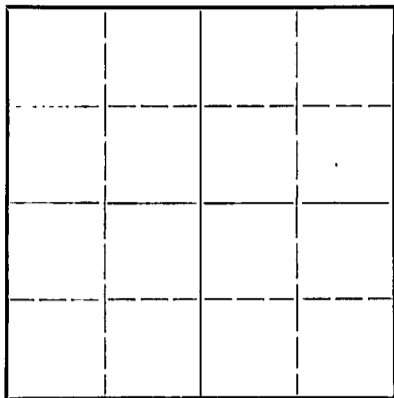

Locate well correctly on above  
Section Plat

Rooks County. Sec. 35 Twp. 10 Rge. 11/E/ '19(W)  
Location as "NE 1/4 NW 1/4 SW 1/4" or footage from lines. NE NE NW  
Lease Owner. Veeder Sup. & Dev. Co.  
Lease Name. McCullough Well No. 1  
Office Address. Cherryvale, Ks.  
Character of Well (completed as Oil, Gas or Dry Hole). Abandoned Oil  
Date well completed. 19.  
Application for plugging filed. 3-9-44 19.  
Application for plugging approved. 3-9-44 19.  
Plugging commenced. 3-14-44 19.  
Plugging completed. 3-14-44 19.  
Reason for abandonment of well or producing formation. Depleted

If a producing well is abandoned, date of last production. 19.  
Was permission obtained from the Conservation Division or its agents before plugging was com-  
menced? Yes

Name of Conservation Agent who supervised plugging of this well. C. T. Alexander  
Producing formation. Depth to top. Bottom. Total Depth of Well. 3513 Feet  
Show depth and thickness of all water, oil and gas formations.

OIL, GAS OR WATER RECORDS

CASING RECORD

Formation	Content	From	To	Size	Put In	Pulled Out

Describe in detail the manner in which the well was plugged, indicating where the mud fluid was placed and the method or methods used in introducing it into the hold. If cement or other plugs were used, state the character of same and depth placed, from.....feet to .....feet for each plug set.

Hole filled with mud, tubing and packer from 3513 to 3004' and mud and bridge to 250'. Cement from 250' to 230', and mud and bridge from 230' to 20'. Cement from 20' to 5'. All mud was used so that it will eventually push down and seal the producing formations.

3-17-48

(If additional description is necessary, use BACK of this sheet)

Correspondence regarding this well should be addressed to. Veeder Sup. & Dev. Co.  
Address. Cherryvale, Ks.

STATE OF Kansas, COUNTY OF Sedgwick, ss.

(employee of owner) or (owner or operator) of the above-described well, being first duly sworn on oath, says: That I have knowledge of the facts, statements, and matters herein contained and the log of the above-described well as filed and that the same are true and correct. So help me God.

(Signature) Veeder Supply & Dev. Co.  
By Donald Blair  
(Address)

SUBSCRIBED AND SWORN to before me this 17 day of March, 1948

My commission expires November 5, 1951  
Notary Public.

