


STATE OF KANSAS  
STATE CORPORATION COMMISSION

WELL PLUGGING RECORD

Give All Information Completely  
Make Required Affidavit  
Mail or Deliver Report to:  
Conservation Division  
State Corporation Commission  
800 Bitting Building  
Wichita, Kansas

Rooks County. Sec. 1 Twp. 10s Rge. (E) 20 (W)  
Location as "NE/CNW $\frac{1}{4}$ SW $\frac{1}{4}$ " or footage from lines NW $\frac{1}{4}$ -SE $\frac{1}{4}$ -S $\frac{1}{4}$   
Lease Owner Champlin Refining Company  
Lease Name Sutor "A" Well No. 2  
Office Address P.O. Dr. #552, Enid, Oklahoma.  
Character of Well (completed as Oil, Gas or Dry Hole) Dry hole  
Date well completed November 24, 1951  
Application for plugging filed November 22, 1951  
Application for plugging approved November 22, (Vegbal) 1951  
Plugging commenced November 24, 1951  
Plugging completed November 24, 1951  
Reason for abandonment of well or producing formation

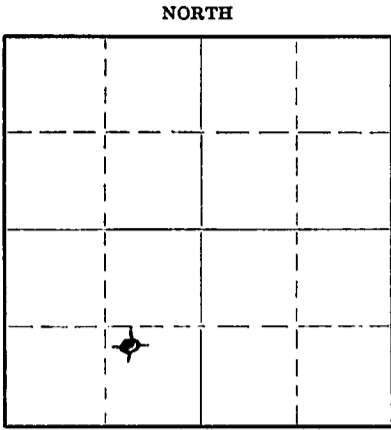

Locate well correctly on above Section Plat

If a producing well is abandoned, date of last production 19...  
Was permission obtained from the Conservation Division or its agents before plugging was commenced? Yes Mr. Eldon Petty, Hays, Kansas.

Name of Conservation Agent who supervised plugging of this well Mr. Eldon Petty, Hays, Kansas.  
Producing formation Depth to top Bottom Total Depth of Well 3925' Feet  
Show depth and thickness of all water, oil and gas formations.


OIL, GAS OR WATER RECORDS

CASING RECORD

| Formation | Content | From | To | Size      | Put In | Pulled Out |
|-----------|---------|------|----|-----------|--------|------------|
|           |         |      |    | 8 5/8" OD | 139'   | None       |
|           |         |      |    |           |        |            |
|           |         |      |    |           |        |            |
Describe in detail the manner in which the well was plugged, indicating where the mud fluid was placed and the method or methods used in introducing it into the hole. If cement or other plugs were used, state the character of same and depth placed, from...feet to...feet for each plug set.

Filled hole with heavy rotary mud from 3925' TD to bottom of surface casing and pushed plug to 150' then set cement plug from top of plug to 110' using 15 sacks of cement then filled hole with heavy rotary mud from top of cement to 35' and set cement plug in top using 10 sacks of cement which set plug from 35' to bottom of cellar.

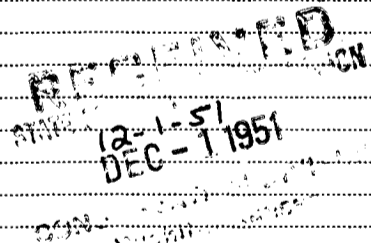

(If additional description is necessary, use BACK of this sheet)

Correspondence regarding this well should be addressed to Champlin Refining Company  
Address P. O. Dr. #552, Enid, Oklahoma.

STATE OF Kansas COUNTY OF Barton, ss.  
S. P. Hall (employee of owner) or ~~owner~~ operator of the above-described well,  
being first duly sworn on oath, says: That I have knowledge of the facts, statements, and matters herein contained and the log of the above-described well as filed and that the same are true and correct. So help me God.

(Signature) S. P. Hall  
P. O. Box 167  
Enid, Kansas (Address)  
November 27th day of November 1951

SUBSCRIBED AND SWORN to before me this 27th day of November 1951  
Notary Public

My commission expires September 10, 1955

10 200  
17 3

SUTOR "A" #2

990' from the South line (FSL),  
and 1650' from the West line (FWL.)  
of the Southwest quarter (SW/4) of  
Section One (1), Township Ten South  
(10S), Range Twenty West (20W), Rooks  
County, Kansas.

Formation Log

|               |                       |
|---------------|-----------------------|
| 0' - 139'     | Sand & shale          |
| 139' - 1135'  | Shale & sand & shells |
| 1135' - 1610' | Shale & sand          |
| 1610' - 1880' | Shale & sand          |
| 1880' - 2280' | Shale & anhydrite     |
| 2280' - 2445' | Shale & lime          |
| 2445' - 2580' | Sand & shale          |
| 2580' - 2685' | Shale & lime          |
| 2685' - 2805' | Lime & shale          |
| 2805' - 2955' | Shale & lime          |
| 2955' - 3150' | Lime & shale          |
| 3150' - 3225' | Lime                  |
| 3225' - 3290' | Lime & shale          |
| 3290' - 3345' | Shale & lime          |
| 3345' - 3555' | Lime                  |
| 3555' - 3585' | Lime (good odor)      |
| 3585' - 3786' | Lime                  |
| 3786' - 3914' | Conglomerate          |
| 3914' - 3925' | Lime                  |
| 3925' - Total | Depth                 |

1 10 20W  
127 3