

15-163-03067-0000


STATE OF KANSAS  
STATE CORPORATION COMMISSION

WELL PLUGGING RECORD

Give All Information Completely  
Make Required Affidavit  
Mail or Deliver Report to:  
Conservation Division  
State Corporation Commission  
800 Bittling Building  
Wichita, Kansas

County. Sec. 1 Twp. 10S Rge. (E) 20 (W)  
Location as "NE/CNW/SW" or footage from lines Rocks  
Lease Owner Champlin Refining Company  
Lease Name Sutor Well No. 7  
Office Address P.O. Dr. 552, Enid, Oklahoma  
Character of Well (completed as Oil, Gas or Dry Hole) Dry Hole  
Date well completed June 30, 19 54  
Application for plugging filed June 30, 19 54  
Application for plugging approved June 30, (Verbal) 19 54  
Plugging commenced June 30, 19 54  
Plugging completed June 30, 19 54  
Reason for abandonment of well or producing formation \_\_\_\_\_

NORTH

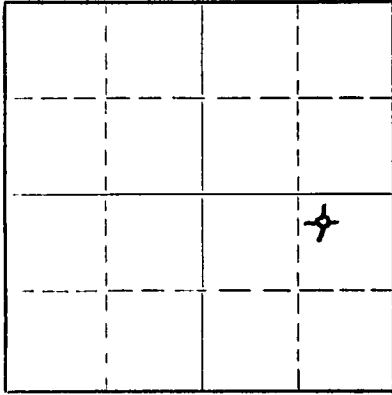

Locate well correctly on above  
Section Plat

If a producing well is abandoned, date of last production \_\_\_\_\_ 19\_\_\_\_  
Was permission obtained from the Conservation Division or its agents before plugging was commenced? Yes

Name of Conservation Agent who supervised plugging of this well Mr. Eldon Petty  
Producing formation \_\_\_\_\_ Depth to top \_\_\_\_\_ Bottom \_\_\_\_\_ Total Depth of Well 3860 Feet  
Show depth and thickness of all water, oil and gas formations.

OIL, GAS OR WATER RECORDS

CASING RECORD

FORMATION	CONTENT	FROM	TO	SIZE	PUT IN	PULLED OUT
				8 5/8" OD	154'	None

Describe in detail the manner in which the well was plugged, indicating where the mud fluid was placed and the method or methods used in introducing it into the hole. If cement or other plugs were used, state the character of same and depth placed, from \_\_\_\_\_ feet to \_\_\_\_\_ feet for each plug set.

Filled hole with heavy rotary mud from 3860' T.D. to 150' and set wood plug at 150' with 1/2 sack of hulls and 15 sacks of cement, then filled hole with heavy mud from top of cement to 40' and set wood plug and 1/2 sack of hulls and 10 sacks of cement to fill hole to top of surface casing.

(Used Halliburton to plug well)

7-6-54

(If additional description is necessary, use BACK of this sheet)

Name of Plugging Contractor Bennett & Roberts (Rotary)  
Address Russell, Kansas


STATE OF Kansas, COUNTY OF Darton, ss.  
J. W. Meyers (employee of owner) or (owner or operator) of the above-described well, being first duly sworn on oath, says: That I have knowledge of the facts, statements, and matters herein contained and the log of the above-described well as filed and that the same are true and correct. So help me God.

(Signature) J. W. Meyers  
P.O. Box 167, Ellinwood, Kansas  
(Address)

SUBSCRIBED AND SWORN TO before me this 2nd day of July, 19 54

N. Kenneth Steiner  
Notary Public.

My commission expires Sept. 10, 1955

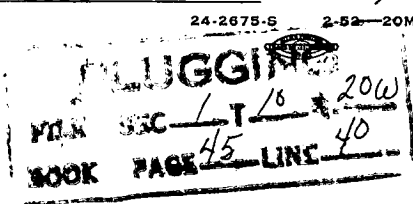

15-163-03067-0000

STATE CORPORATION COMMISSION  
CONSERVATION DIVISION  
WICHITA, KANSAS

PROPERTY Rooks S.W.C. 1 TWP. 10S RGE. 20W

OPERATING COMPANY Champlin Refining Company

OFFICE ADDRESS Box 552 - Enid, Oklahoma

WELL NAME Sutor "A" WELL NO. 7

WELL LOGARITHM NW/4 NE/4 SE/4 or 990' from the East line  
and 2310' from the South line of the SE/4

CHARACTER OF WELL Dry Hole

DATE OF COMPLETION June 19, 1954 DRILLING COMPLETED June 30, 1954

SIZE	TYPE	DEPTH	NAME	FEET	AMOUNT FURLED	CEMENT
8-5/8"	28#	8 Rd	National	157.08'	None	125 Sacks

FORMATION RECORD

	TOPS	BOTTOM	TOPS	BOTTOM
Surface Clay	0	10	Elevation: 2239' R.B.	
Sand	10	135	Geological Tops:	
Shale	135	790	Topeka	3235
Sale-Red Bed	790	900	Heebner	3442
Shale-Sand	900	1010	Toronto	3460
Shale-Shells	1010	1160	Lansing K.C.	3480
Sand	1160	1390	Conglomerate	3734
Shale-Shells	1390	1460		
Shale	1460	1505		
Shale-Sand	1505	1670		
Anhydrite	1670	1705		
Shale	1705	1790		
Shale-Lime-Shells	1790	2205		
Lime	2205	2385		
Shale-Lime	2385	2718		
Lime	2718	2900		
Shale-Lime	2900	2997		
Lime	2997	3117		
Shale-Lime	3117	3224		
Lime	3224	3594		
Shale-Lime	3594	3776		
Conglomerate-Chert	3776	3805		
Cherty Conglomerate	3805	3848		
Conglomerate	3848	3860 T.D.		

RECEIVED  
STATE CORPORATION COMMISSION  
JUL 20 1954  
CONSERVATION DIVISION  
Wichita, Kansas

Fluentworth  
Superintendent

Don Hill  
Notary Public

Subscribed and sworn to before me  
this 8 day of July, 1954  
at Wichita, Kansas August 14, 1954