


STATE OF KANSAS  
STATE CORPORATION COMMISSION

Give All Information Completely  
Make Required Affidavit  
Mail or Deliver Report to:  
Conservation Division  
State Corporation Commission  
800 Bittig Building  
Wichita, Kansas

WELL PLUGGING RECORD

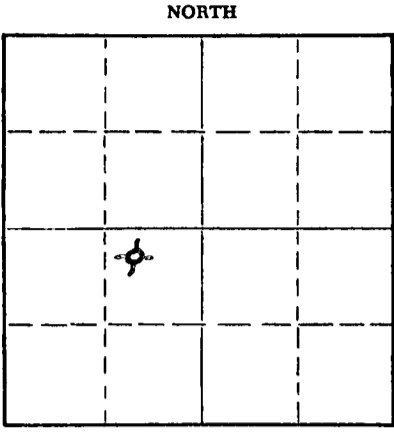

Locate well correctly on above  
Section Plat

Rooks County. Sec. 1 Twp. 10S Rge. 20 (E) 20 (W)  
Location as "NE/CNW/SW" or footage from lines NW NE SW  
Lease Owner Champlin Oil & Refining Co.  
Lease Name Sutor A Well No. 8  
Office Address Box 167, Ellinwood, Kansas  
Character of Well (completed as Oil, Gas or Dry Hole) Dry hole  
Date well completed April 14 19 59  
Application for plugging filed April 14 19 59  
Application for plugging approved April 14 (Verbal) 19 59  
Plugging commenced April 14 19 59  
Plugging completed April 14 19 59  
Reason for abandonment of well or producing formation \_\_\_\_\_

If a producing well is abandoned, date of last production \_\_\_\_\_ 19 \_\_\_\_\_  
Was permission obtained from the Conservation Division or its agents before plugging was commenced? Yes

Name of Conservation Agent who supervised plugging of this well Eldon Petty  
Producing formation \_\_\_\_\_ Depth to top \_\_\_\_\_ Bottom \_\_\_\_\_ Total Depth of Well 3838 Feet  
Show depth and thickness of all water, oil and gas formations.

OIL, GAS OR WATER RECORDS

CASING RECORD

FORMATION	CONTENT	FROM	TO	SIZE	PUT IN	PULLED OUT
				8-5/8" OD	290'	None

Describe in detail the manner in which the well was plugged, indicating where the mud fluid was placed and the method or methods used in introducing it into the hole. If cement or other plugs were used, state the character of same and depth placed, from \_\_\_\_\_ feet to \_\_\_\_\_ feet for each plug set.

Filled hole with heavy rotary mud from 3838' TD to 600' set plug and pumped in 20 sacks of cement then filled hole with heavy mud to 180' and set plug and pumped in 20 sacks of cement, then filled hole with heavy mud to 40' and dumped in 1/2 sack of hulls and pumped in 15 sacks of cement filling hole to bottom of cellar.

4-23-59

(If additional description is necessary, use BACK of this sheet)

Name of Plugging Contractor H-30 Inc.  
Address 711 Petroleum Building, Wichita, Kansas

STATE OF Kansas, COUNTY OF Barton, ss.  
J. W. Meyers (employee of owner) or ~~(owner or operator)~~ of the above-described well, being first duly sworn on oath, says: That I have knowledge of the facts, statements, and matters herein contained and the log of the above-described well as filed and that the same are true and correct. So help me God.

(Signature) J. W. Meyers  
Box 167, Ellinwood, Kansas  
(Address)

SUBSCRIBED AND SWORN TO before me this 18th day of April, 19 59

My commission expires 5-22-62 \_\_\_\_\_ Notary Public.

PLUGGING  
FILE SEC. 1 T. 10 R. 20W  
BOOK PAGE 33 LINE 15

15-163-194 27-0000

KANSAS GEOLOGICAL SOCIETY  
KANSAS WELL LOG BUREAU - KANSAS WELL SAMPLE BUREAU  
KANSAS GEOLOGICAL SOCIETY BUILDING  
508 EAST MURDOCK - WICHITA, KANSAS


COMPANY Champlin Oil & Refining Company  
FARM Sutor A NO. 8

SEC. 1 T. 10 R. 20  
LOC. NW NE SW 1/4

TOTAL DEPTH 3838  
COMM. 4/3/59 COMP. 4/14/59  
SHOT OR TREATED  
CONTRACTOR H-30, Inc.  
ISSUED

COUNTY Rooks

KANSAS

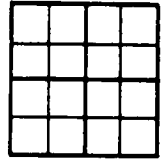

CASING  
20 10  
15 8 289'  
12 6  
13 5

ELEVATION 2236 G.L.  
2238 D.F.  
2241 K.B.  
PRODUCTION D & A

FIGURES INDICATE BOTTOM OF FORMATIONS

Surface hole 295'  
Shale & shells 720'  
Dakota Clay and Sand 1010'  
Shale & shells & sand stka 1165'  
Sand 1410'  
Shale & Shells 1580'  
Shale - Red Bed 1677'  
Anhydrite 1719'  
Shale & shells 2310'  
Shale with Lime stks 2435'  
Shale & Lime 2840'  
Shale 2925'  
Shale & Lime 3485'  
Lime 3526'  
Kansas City Lime 3590'  
Lime 3662'  
Kansas City Lime 3720'  
Lime 3770'  
Conglomerate 3838'

Formation tops:

Sample		Elec. Log
Heebner	3454	3450
Toronto		3472
Lansing K.C.	3494	3491
Base K, C,	3710	3707
Conglomerate	3754	3753

RECORDED  
INDEXED  
APR 23 1959  
REGISTRATION DIVISION  
Wichita, Kansas

I hereby certify that this is a true and correct log of the above described well as shown by the drilling reports.

H-30, Inc.

By C. L. Spruency

STATE OF KANSAS  
SS,  
COUNTY OF SEDGWICK

Subscribed and sworn to before me, a notary public, in and for said County and State this 17 of April 1959.

Rose Jones  
Notary Public

My Commission Expires Feb. 13, 1960.

PLUGGING  
FILE SEC. 1 T. 10 R. 20 W  
BOOK PAGE 32 LINE 15