

STATE OF KANSAS
STATE CORPORATION COMMISSION


WELL PLUGGING RECORD

Give All Information Completely
Make Required Affidavit
Mail or Deliver Report to:
Conservation Division
State Corporation Commission
800 Bitting Building
Wichita, Kansas

OR
FORMATION PLUGGING RECORD

Strike out upper line
when reporting plug-
ging off formations.

Rooks County. Sec. 1 Twp. 10S. Rge. (E) 20 (W)
Location as "NE $\frac{1}{4}$ NW $\frac{1}{4}$ SW $\frac{1}{4}$ " or footage from lines SW $\frac{1}{4}$ - NE $\frac{1}{4}$ - NE $\frac{1}{4}$
Lease Owner Champlin Refining Company
Lease Name Graham Well No. 2
Office Address P.O. Dr. #552 Enid, Oklahoma
Character of Well (completed as Oil, Gas or Dry Hole) Dry Hole
Date well completed May 12, 19 52
Application for plugging filed May 16, 19 52
Application for plugging approved May 12, (Verbal) 19 52
Plugging commenced May 12, 19 52
Plugging completed May 12, 19 52
Reason for abandonment of well or producing formation

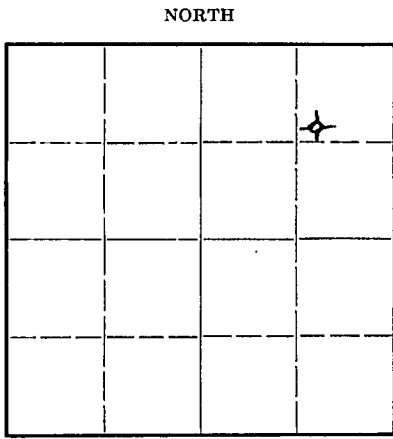

Locate well correctly on above Section Flat

If a producing well is abandoned, date of last production 19...
Was permission obtained from the Conservation Division or its agents before plugging was com-
menced? Yes

Name of Conservation Agent who supervised plugging of this well Mr. Eldon Petty, Hays, Kansas
Producing formation Depth to top Bottom Total Depth of Well 3912 Feet
Show depth and thickness of all water, oil and gas formations.

OIL, GAS OR WATER RECORDS

CASING RECORD

Formation	Content	From	To	Size	Put In	Pulled Out
				8 5/8" OD	157	None

Describe in detail the manner in which the well was plugged, indicating where the mud fluid was placed and the method or methods used in introducing it into the hold. If cement or other plugs were used, state the character of same and depth placed, from...feet to...feet for each plug set.

Filled hole with heavy rotary mud from 3912' T.D. to 150' and set plug using 15 sacks cement then filled hole with heavy rotary mud from top of cement to 40' and set plug from 40' to bottom of celler using 10 sacks cement.

(If additional description is necessary, use BACK of this sheet)

Correspondence regarding this well should be addressed to Champlin Refining Company
Address P.O. Dr. #552
Enid, Oklahoma

STATE OF Kansas COUNTY OF Barton, ss.
S. P. Hall (employee of owner) or (Notary Public)

being first duly sworn on oath, says: That I have knowledge of the facts, statements, and matters herein contained and the log of the above-described well as filed and that the same are true and correct. So help me God.

(Signature) S. P. Hall
P.O. Box 167
Enid, Kansas (Address)

SUBSCRIBED AND SWORN to before me this 16th day of May, 1952

My commission expires Sept. 10, 1955
N. Kenneth Stiver Notary Public

CONSERVATION DIVISION
Wichita, Kansas

PLUGGING
FILE SEC. 1-10-20
BOOK PAGE 15 LINE 3

Rooks 1 10S 20W
 Champlin Refining Company
 Box 552 - Enid, Oklahoma
 Lena Graham 2
 SW/4 NE/4 NE/4 or 990' from North Line
 and 990' from East Line of NE/4
 Dry Hole

April 29, 1952

May 11, 1952

8-5/8" 28# 8 Rd National 169.34 - 100 Sacks

Sand-Shale	0	170
Shale-Shells	170	450
Shale-Sand-Shells	450	1400
Shale	1400	1665
Anhydrite	1665	1705
Shale-Redbed	1705	1950
Shale-Shells	1950	2415
Shale-Lime	2415	3545
Lime	3545	3562
Shale-Lime	3562	3650
Lime	3650	3705
Lime-Conglomerate	3705	3750
Shale-Lime	3750	3790
Conglomerate	3790	3888
Lime	3888	3912 T.D.

Geological Tops:

Heebner	3465
Lansing	3504
Base Kansas City	3725
Conglomerate	3767
Simpson	3876
Arbuckle	3881

Elevation: 2,243' K.B.

RECEIVED
 STATE CORPORATION COMMISSION

MAY 21 1952

CONSERVATION DIVISION
 Wichita, Kansas

J. M. Mentzer

Don Price