


WELL PLUGGING RECORD

Give All Information Completely
Make Required Affidavit
Mail or Deliver Report to:
Conservation Division
State Corporation Commission
800 Biting Building
Wichita, Kansas

NORTH

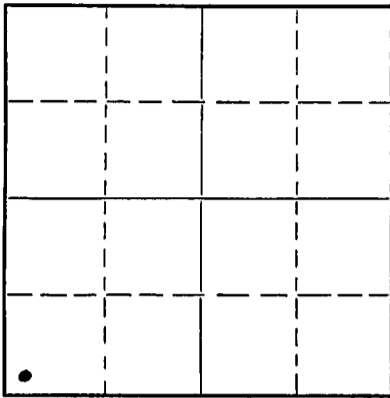

Locate well correctly on above Section Plat

Rooks County. Sec. 1 Twp. 10s Rge. (E) 20 (W)
Location as "NE/CNW $\frac{1}{4}$ SW $\frac{1}{4}$ " or footage from lines SW $\frac{1}{4}$ -SW $\frac{1}{4}$ -SW $\frac{1}{4}$
Lease Owner Champlin Refining Company
Lease Name Earl Sutor Well No. 1 "A"
Office Address P. O. Dr. #552, Enid, Oklahoma.
Character of Well (completed as Oil, Gas or Dry Hole) Dry hole
Date well completed June 10, 19 51
Application for plugging filed June 10, 19 51
Application for plugging approved June 10, 19 51
Plugging commenced June 10, 19 51
Plugging completed June 10, 19 51
Reason for abandonment of well or producing formation

If a producing well is abandoned, date of last production 19
Was permission obtained from the Conservation Division or its agents before plugging was commenced? Yes

Name of Conservation Agent who supervised plugging of this well Eldon Petty, Hays, Kansas.
Producing formation Depth to top Bottom Total Depth of Well 3850' Feet
Show depth and thickness of all water, oil and gas formations.

OIL, GAS OR WATER RECORDS

CASING RECORD

Formation	Content	From	To	Size	Put In	Pulled Out
				8 5/8"	212'	None

Describe in detail the manner in which the well was plugged, indicating where the mud fluid was placed and the method or methods used in introducing it into the hole. If cement or other plugs were used, state the character of same and depth placed, from feet to feet for each plug set.

Filled hole with heavy rotary mud from 3850' TD and setplug at 190' and pumped in 15 sacks of cement then filled hole ~~XX~~ with heavy rotary mud from top of cement and set plug at 40' from surface and filled hole to top using 10 sacks of cement. Used Globe Oil Well Cementing Company to plug this well.

6-26-51

(If additional description is necessary, use BACK of this sheet)

Correspondence regarding this well should be addressed to Champlin Refining Company
Address P. O. Dr. #552, Enid, Oklahoma.

STATE OF Kansas, COUNTY OF Barton, ss.
S. P. Hall (employee of owner) or (~~owner~~) of the above-described well, being first duly sworn on oath, says: That I have knowledge of the facts, statements, and matters herein contained and the log of the above-described well as filed and that the same are true and correct. So help me God.

(Signature) S. P. Hall
Ellinwood, Kansas.
(Address)

SUBSCRIBED AND SWORN to before me this 25th day of June 1951
N. Kenneth Sturdivant
Notary Public.

My commission expires October 24, 1951

PLUGGING
FILE SEC 1 T 10 R 20W
BOOK PAGE 88 LINE 28

CHAMPLIN REFINING COMPANY

EARL SUTOR #1 "A" WELL

330' from the South line and
330' from the West line of the
Southwest Quarter of Section
1-10s-20w, Rooks County, Kansas.

- 0' - 1215' Sand and shale
- 1215' - 1580' Shale, sand and Redbed
- 1580' - 1665' Sand and shale
- 1665' - 1700' Anhydrite
- 1700' - 1910' Sand and shale
- 1910' - 2135' Shale and shells
- 2135' - 2630' Shale and lime
- 2630' - 2755' Shale, lime and sand
- 2755' - 3730' Shale and lime
- 3730' - 3785' Conglomerate
- 3785' - 3814' Chert and shale
- 3814' - 3850' Cherty lime
- 3850' - Total Depth

PLUGGING
177 028-1-T-LDR 204
88 28