

KANSAS CORPORATION COMMISSION
OIL & GAS CONSERVATION DIVISION

Form CP-1
September 2003
Form must be Typed
Form must be Signed
All blanks must be Filled

WELL PLUGGING APPLICATION

Please TYPE Form and File ONE Copy

API # 15- 067-21066-0000 (Identifier Number of this well). This must be listed for wells drilled since 1967; if no API # was issued.

Indicate original spud or completion date 7/10/1990 (spud)

Well Operator: Presco Western, LLC KCC License #: 32309

Address: 5665 Flatiron Parkway (Owner/Company Name) City: Boulder (Operator's)

State: CO Zip Code: 80301 Contact Phone: 303 305-1163

Lease: W.B. Scherling Well #: 29-1 Sec. 29 Twp. 29 R. 38 East West

C - SW - NW - NW Spot Location/QQQQ County Grant

4.290 Feet from (in exact footage) North South (from nearest outside section corner) Line of Section (not Lease Line)

4.950 Feet from (in exact footage) East West (from nearest outside section corner) Line of Section (not Lease Line)

Check One: Oil Well Gas Well D&A Cathodic Water Supply Well
 SWD Docket # _____ ENHR Docket # _____ Other _____

Conductor Casing Size: 20" Set at: 40' Cemented with: 6 Sacks

Surface Casing Size: 8-5/8" Set at: 1,831' Cemented with: 815 Sacks

Production Casing Size: 5-1/2" Set at: 5,926' Cemented with: 655 Sacks

List (ALL) Perforations and Bridgeplug Sets: 5,667 - 5,674' (St. Louis)

Elevation: 3,139 (G.L. K.B.) T.D. 5,927' PBDT 5,830' Anhydrite Depth _____
(Stone Corral Formation)

Condition of Well: Good Poor Casing Leak Junk in Hole

Proposed Method of Plugging (attach a separate page if additional space is needed): Plug 1: CIBP @ +/- 5,620 w/ 2 SKS cmt. Plug 2: 20 SKS cmt @ +/- 2,890'. Plug 3 & 4: Shoot squeeze perfs @ +/- 1,860', circulate cmt to surface, leave 50 SKS in csq. Plug 5: 50 SKS cmt @ +/- 600'. Plug 6: 20 SKS @ surface.

Is Well Log attached to this application as required? Yes No Is ACO-1 filed? Yes No

If not explain why? _____

KANSAS CORPORATION COMMISSION

JUN 15 2009

RECEIVED

Plugging of this Well will be done in accordance with K.S.A. 55-101 et. seq. and the Rules and Regulations of the State Corporation Commission

List Name of Company Representative authorized to be in charge of plugging operations:

Steve Ridenour Phone: 620 655-3459

Address: 303 S. Stubbs Rd. City/State Ulysses/KS 67880

Plugging Contractor Presco Western (Basic Energy) KCC License # 32309
(Company Name) (Contractor's)

Address 5665 Flatiron Parkway Phone: 303 305-1163

Proposed Date and Hour of Plugging (If known?): 7-17-09 1000 AM

Payment of the Plugging Fee (K.A.R. 82-3-118) will be guaranteed by Operator or Agent

Date: 6/12/2009 Authorized Operator / Agent: Keli Kowalski
(Signature)

*Well Plugged - KCC-PKT
Mail to: KCC - Conservation Division, 130 S. Market - Room 2078, Wichita, Kansas 67202


Dist 1
PKT

ELLORA ENERGY

Grant Cty.

WB SCHERLING 29-1
15-067-21066

PROPOSED

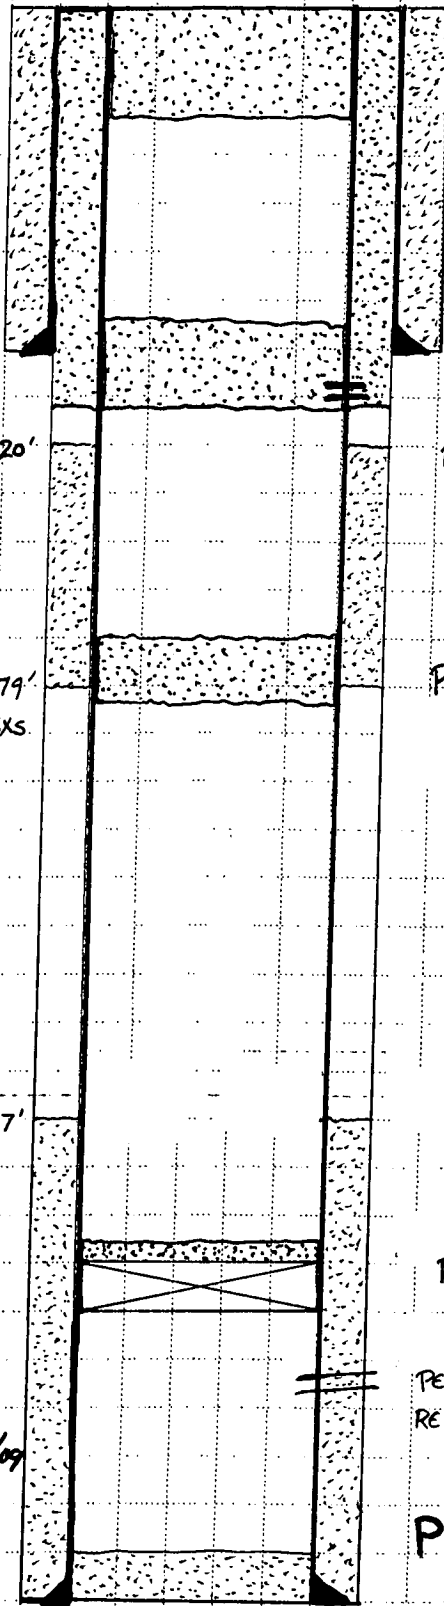

Plug 6: 20 SXS @ surface

PLUG #5 - ~~60~~⁵⁰ SXS CMT @ +/- 600'

SURFACE CSG

8 5/8" 24 # K-55 @ 1,831'
CMT'D W/ 815 SXS

PLUGS #3 & #4 - SHOOT SQUEEZE PERFS @
+/- 1,860' CIRCULATE CMT TO SURFACE,
LEAVE ~~50~~^{RV} SXS IN CSG
50

PLUG #2 - 20 SXS CMT @ +/- 2,890'

DV TOOL @ 2,879'
CMT'D W/ 240 SXS

KANSAS CORPORATION COMMISSION

JUN 15 2009

RECEIVED

PLUG #1 - CIBP @ +/- 5,620' w/ 2 SXS CMT

PERFS 5,667' - 5,674' (ST. LOUIS)
RE-PERFD 5,667' - 5,671' (ST. LOUIS)

PRODUCTION CSG

5 1/2" 15.5 # K-55 @ 5,918'
CMT'D W/ 390 SXS

* Verbal - Dwight /
Vance on 6/10/09