

KANSAS CORPORATION COMMISSION
OIL & GAS CONSERVATION DIVISION
WELL PLUGGING APPLICATION
Please TYPE Form and File ONE Copy

Form CP-1
September 2003
This Form must be Typed
Form must be Signed
All blanks must be Filled

API # 15 - 185-21821 - 0000 (Identifier Number of this well). This must be listed for wells drilled since 1967; if no API # was issued,

indicate original spud or completion date 7/14/83

Well Operator: FALCON EXPLORATION INC. KCC License #: 5316
(Owner / Company Name) (Operator's)

Address: 125 N. MARKET, SUITE 1252 City: WICHITA

State: KS Zip Code: 67202 Contact Phone: (316) 262 - 1378

Lease: WILSON Well #: 1 Sec. 5 Twp. 25 S. R. 14 East West

NW - NE - SW - Spot Location / QQQQ County: STAFFORD

2310 Feet (in exact footage) From North / South (from nearest outside section corner) Line of Section (Not Lease Line)

1650 Feet (in exact footage) From East / West (from nearest outside section corner) Line of Section (Not Lease Line)

Check One: Oil Well Gas Well D&A Cathodic Water Supply Well
 SWD Docket # _____ ENHR Docket # _____ Other: _____

Conductor Casing Size: _____ Set at: _____ Cemented with: _____ Sacks

Surface Casing Size: 8-5/8" Set at: 346 Cemented with: 250 Sacks

Production Casing Size: 4-1/2 Set at: 4411 Cemented with: 250 Sacks

List (ALL) Perforations and Bridgeplug Sets: 3858-3863'

Elevation: 2001 (G.L. / K.B.) T.D.: 4410 PBTD: _____ Anhydrite Depth: EST 890'
(Stone Corral Formation)

Condition of Well: Good Poor Casing Leak Junk in Hole

Proposed Method of Plugging (attach a separate page if additional space is needed): PER KCC INSTRUCTIONS

Is Well Log attached to this application as required? Yes No Is ACO-1 filed? Yes No

If not explain why? _____

Plugging of this Well will be done in accordance with K.S.A. 55-101 et. seq. and the Rules and Regulations of the State Corporation Commission.

List Name of Company Representative authorized to be in charge of plugging operations: LEON KUHN

Phone: (785) 483 - 1559

Address: P O BOX 551 City / State: RUSSELL, KS 67665

Plugging Contractor: H-D OILFIELD SERVICE INC. KCC License #: 32970
(Company Name) (Contractor's)

Address: P O BOX 87, BAZINE KS 67516 Phone: (785) 398 - 2289

Proposed Date and Hour of Plugging (if known?): AS SOON AS RIG IS AVAILABLE.

Payment of the Plugging Fee (K.A.R. 82-3-118) will be guaranteed by Operator or Agent
Date: 9/8/09 Authorized Operator / Agent: [Signature] (Signature)

Mail to: KCC - Conservation Division, 130 S. Market - Room 2078, Wichita, Kansas 67202

RECEIVED
SEP 08 2009
KCC WICHITA

Falcon Exploration, Inc.

Well: Wilson , #1 , WILSO--
Operator: FALCON EXPLORATION, INC.
Location: NW NE SW SECTION 5-25S-14W, STAF
Legal: SW/4 SECTION 5-25S-14W, STAFFO

Dir:

Spud Date: 7/14/83
Drilling Finished: 7/26/83
Completion Date: 8/10/83
First Production: 8/17/83

PUMPING DATA:

PU: SENTRY 114D
PM: FAIRBANKS-MORSE GAS ENGINE
BHP: 2X1-1/2X12'
Anchor: 15' MUD ANCHOR

PRODUCTION FACILITY:

2310 N, 1650 E, SWC

TUBING #1:


Type	#Jts	Size	Wt#/f	Grade	Set@
EUE	119	2-3/8"	4.7#		3869

ROD:

Type	#Rods	Size	Length
POLISHED	1		16
PONY	1	3/4	8
SUCKER	153	3/4	3825
pony	1	3/4	2

HISTORY:

RECEIVED
SEP 08 2009
KCC WICHITA

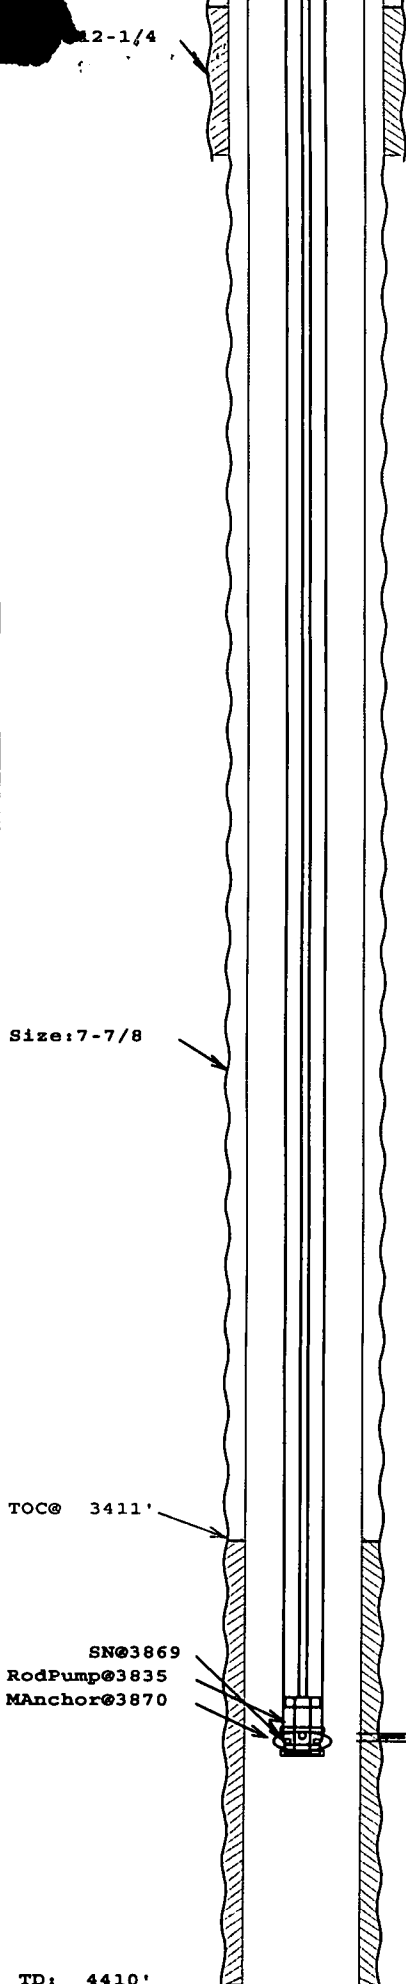

8-5/8" ,24# #,NEW csg,@346'
w/250 BX

Size:7-7/8

TOC@ 3411'

SN@3869
RodPump@3835
MAnchor@3870

3858 - 3863 LANSING 4

TD: 4410'

4-1/2" ,10.5##,R-3 csg,@4411'
w/250 BX

Input by:
Approved by:
Last Update: 8/26/2009



CORPORATION COMMISSION

Mark Parkinson, Governor Thomas E. Wright, Chairman Michael C. Moffet, Commissioner Joseph F. Harkins, Commissioner

NOTICE OF RECEIPT OF WELL PLUGGING APPLICATION (CP-1)

FALCON EXPLORATION, INC.
125 N MARKET STE 1252
WICHITA, KS 67202-1719

September 15, 2009

Re: WILSON #1
API 15-185-21821-00-00
5-25S-14W, 2310 FSL 1650 FWL
STAFFORD COUNTY, KANSAS

Dear Operator:

This letter is to notify you that the Conservation Division has received your plugging proposal, form CP-1, for the above well and has reviewed the proposal for completeness. The central office will now forward your CP-1 to the district office listed below for review of the proposed plugging method. **Please contact the district office for approval of your proposed plugging method at least five (5) days before plugging the well, pursuant to K.A.R. 82-3-113(b). If a workover pit will be used during the plugging of the well it must be permitted. A CDP-1 form must be filed and approved prior to the use of the pit in accordance with K.A.R. 82-3-600.**

The Conservation Division's review of form CP-1, either in the central or district office, does not include an inquiry into well ownership or the filing operator's legal right to plug the well. This notice in no way constitutes authorization to plug the above well by persons not having legal rights of ownership or interest in the well.

This notice is void after March 14, 2010. The CP-1 filing does not bring the above well into compliance with K.A.R. 82-3-111 with regard to the Commission's temporary abandonment requirements.

Sincerely,

Steve Bond
Production Department Supervisor

District: #1
210 E Frontview, Suite A
Dodge City, KS 67801
(620) 225-8888