

PLAT AND CERTIFICATION OF ACREAGE ATTRIBUTABLE TO AN OIL WELL

State Corporation Commission, Conservation Division
200 Colorado Derby Bldg. Wichita, Kansas 67202



OPERATOR Mustang Companies, Inc.
LEASE NAME Pirotte
WELL NUMBER 7
FIELD Vohs
NUMBER OF ACRES ATTRIBUTED TO WELL 10

LOCATION OF WELL:

660 feet north of SE corner
1650 feet west of SE corner
11 Sec. 10S T. 19W R.
COUNTY Rooks

PLAT

(Show location of well and shade attributable acreage)
(Show footage to nearest lease or unit boundary line)

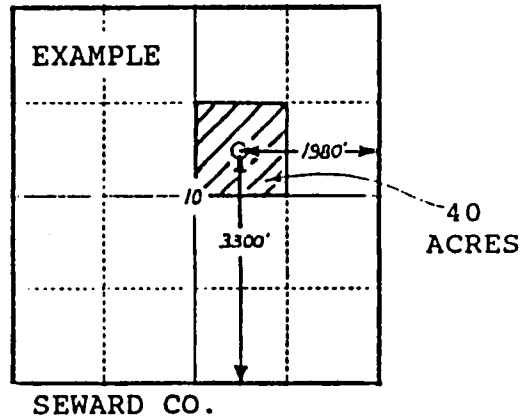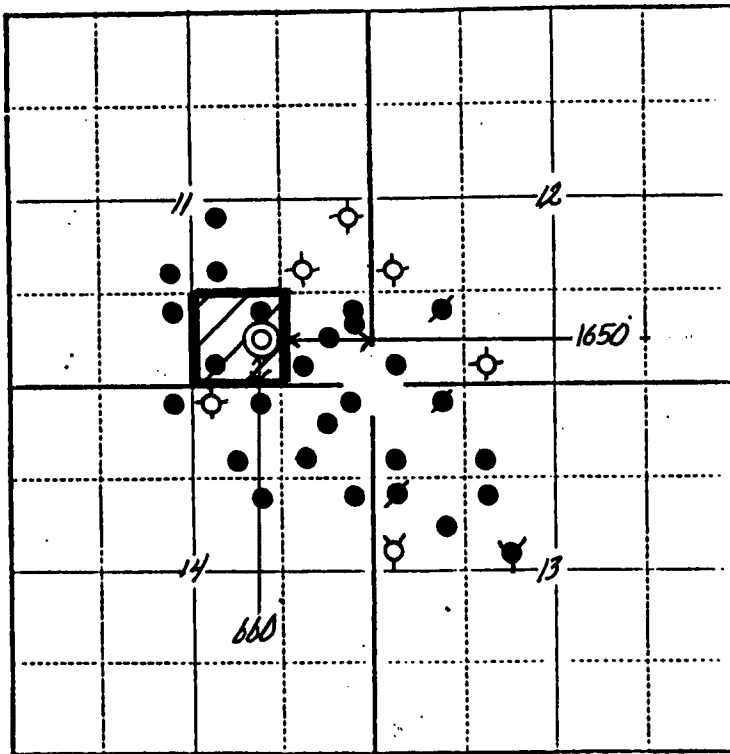

The undersigned hereby certifies that he is Chief Geologist
for Mustang Companies, Inc. (Co.), a duly authorized agent, that all
information shown hereon is true and correct to the best of his knowledge and
belief, and that all acreage claimed as attributable to the well named herein
is held by production from that well.

Subscribed and sworn to before me on this 11th day of September, 1990

My Commission expires July 21, 1991

NOTARY PUBLIC-STATE OF KANSAS
ARLENE VALLIQUETTE
My Appt. Exp. 7-21-91
STATE CORPORATION COMMISSION

(6-1989)

SEP 12 1990