

For KCC Use: 11-14-2009
Effective Date: 4
District # 4
SGA? Yes No

KANSAS CORPORATION COMMISSION
OIL & GAS CONSERVATION DIVISION

Form C-1
October 2007

Form must be Typed
Form must be Signed
All blanks must be Filled

NOTICE OF INTENT TO DRILL

Must be approved by KCC five (5) days prior to commencing well

Expected Spud Date: 11/01/2009
month day year

OPERATOR: License# 33699
Name: T-N-T Engineering, Inc.
Address 1: 3711 Maplewood Ave, Suite 201
Address 2: _____
City: Wichita Falls State: TX Zip: 76308 + _____
Contact Person: Hal Gill
Phone: 940.691.9157 ext 113
CONTRACTOR: License# 33493
Name: American Eagle Drilling LLC

Spot Description: _____
SE SE NW NE Sec. 36 Twp. 12 S. R. 16 E W
(Q/Q/Q) 1,296 feet from N / S Line of Section
1,329 feet from E / W Line of Section

Is SECTION: Regular Irregular?
(Note: Locate well on the Section Plat on reverse side)
County: Ellis
Lease Name: L. L. Austin Well #: 11
Field Name: Fairport
Is this a Prorated / Spaced Field? Yes No
Target Formation(s): Arbuckle Conglomerate-Lansing Kansas City-Toronto,Plattsmouth,Big Spring, Lecompton

Well Drilled For: Oil Gas Seismic: _____ # of Holes
 Enh Rec Storage Disposal
 Other: _____
Well Class: Infield Pool Ext. Wildcat Other
Type Equipment: Mud Rotary Air Rotary Cable
 If OWWO: old well information as follows:

* Nearest Lease or unit boundary line (in footage): 25
Ground Surface Elevation: 1899 feet MSL
Water well within one-quarter mile: Yes No
Public water supply well within one mile: Yes No
Depth to bottom of fresh water: 180
Depth to bottom of usable water: 440 520
Surface Pipe by Alternate: I II
Length of Surface Pipe Planned to be set: 950
Length of Conductor Pipe (if any): _____
Projected Total Depth: 3400
Formation at Total Depth: Arbuckle

Operator: _____
Well Name: _____
Original Completion Date: _____ Original Total Depth: _____

Water Source for Drilling Operations:
 Well Farm Pond Other: _____
DWR Permit #: _____ (Note: Apply for Permit with DWR)

Directional, Deviated or Horizontal wellbore? Yes No
If Yes, true vertical depth: _____
Bottom Hole Location: _____
KCC DKT #: 10-CONS-091-CWLE

Will Cores be taken? Yes No
If Yes, proposed zone: _____

RECEIVED

NOV 09 2009

AFFIDAVIT

The undersigned hereby affirms that the drilling, completion and eventual plugging of this well will comply with K.S.A. 55 et. seq.
It is agreed that the following minimum requirements will be met:

KCC WICHITA

1. Notify the appropriate district office **prior** to spudding of well;
2. A copy of the approved notice of intent to drill **shall be** posted on each drilling rig;
3. The minimum amount of surface pipe as specified below **shall be set** by circulating cement to the top; in all cases surface pipe **shall be set** through all unconsolidated materials plus a minimum of 20 feet into the underlying formation.
4. If the well is dry hole, an agreement between the operator and the district office on plug length and placement is necessary **prior to plugging**;
5. The appropriate district office will be notified before well is either plugged or production casing is cemented in;
6. If an ALTERNATE II COMPLETION, production pipe shall be cemented from below any usable water to surface within **120 DAYS** of spud date.
Or pursuant to Appendix "B" - Eastern Kansas surface casing order #133,891-C, which applies to the KCC District 3 area, alternate II cementing must be completed within 30 days of the spud date or the well shall be plugged. **In all cases, NOTIFY district office** prior to any cementing.

I hereby certify that the statements made herein are true and correct to the best of my knowledge and belief.

Date: 9-14-09 Signature of Operator or Agent: Hal Gill Title: Ks. Area Engineer

For KCC Use ONLY
API # 15 - 051-25932-00-00
Conductor pipe required None feet
Minimum surface pipe required 540 feet per ALT I II
Approved by: Hal Gill 11-9-2009
This authorization expires: 11-9-2010
(This authorization void if drilling not started within 12 months of approval date.)
Spud date: _____ Agent: _____

Remember to:

- File Drill Pit Application (form CDP-1) with Intent to Drill;
- File Completion Form ACO-1 within 120 days of spud date;
- File acreage attribution plat according to field proration orders;
- Notify appropriate district office 48 hours prior to workover or re-entry;
- Submit plugging report (CP-4) after plugging is completed (within 60 days);
- Obtain written approval before disposing or injecting salt water.
- If this permit has expired (See: authorized expiration date) please check the box below and return to the address below.

Well Not Drilled - Permit Expired Date: _____
Signature of Operator or Agent: _____

36 12 16 E W

IN ALL CASES PLOT THE INTENDED WELL ON THE PLAT BELOW

Plat of acreage attributable to a well in a prorated or spaced field

If the intended well is in a prorated or spaced field, please fully complete this side of the form. If the intended well is in a prorated or spaced field complete the plat below showing that the well will be properly located in relationship to other wells producing from the common source of supply. Please show all the wells and within 1 mile of the boundaries of the proposed acreage attribution unit for gas wells and within 1/2 mile of the boundaries of the proposed acreage attribution unit for oil wells.

API No. 15 - 051-25932-00-00
 Operator: T-N-T Engineering, Inc.
 Lease: L. L. Austin
 Well Number: 11
 Field: Fairport

Location of Well: County: Ellis
 1,296 feet from N / S Line of Section
 1,329 feet from E / W Line of Section
 Sec. 36 Twp. 12 S. R. 16 E W

Number of Acres attributable to well: 10
 QTR/QTR/QTR/QTR of acreage: SE - SE - NW - NE



Is Section: Regular or Irregular

If Section is irregular, locate well from nearest corner boundary.

Section corner used: NE NW SE SW

PLAT

*(Show location of the well and shade attributable acreage for prorated or spaced wells.)
 (Show footage to the nearest lease or unit boundary line.)*

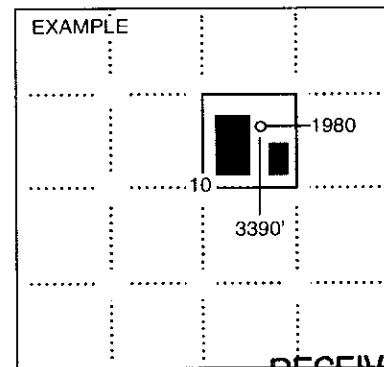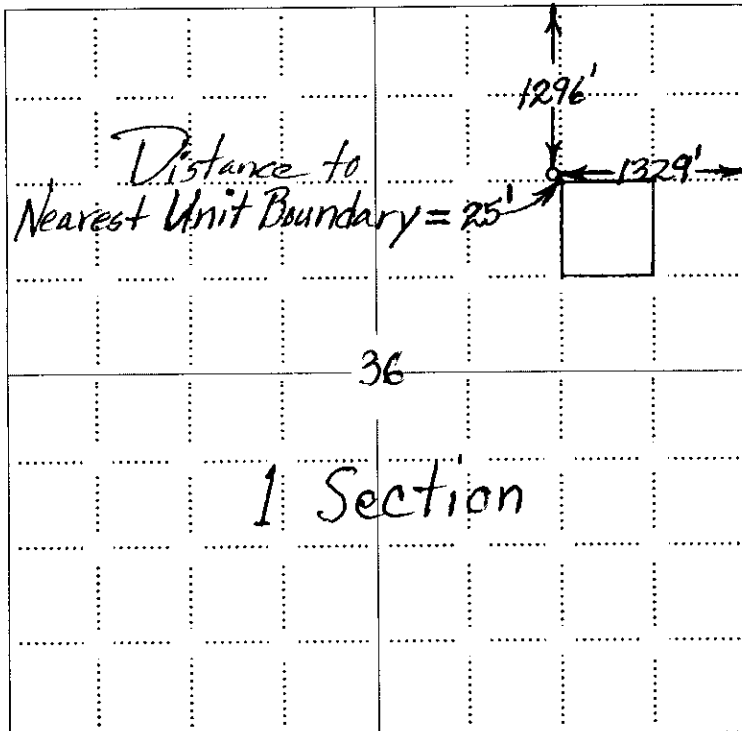

SEWARD CO.

RECEIVED

NOV 09 2009

KCC WICHITA

In plotting the proposed location of the well, you must show:

1. The manner in which you are using the depicted plat by identifying section lines, i.e. 1 section, 1 section with 8 surrounding sections, 4 sections, etc.
2. The distance of the proposed drilling location from the south / north and east / west outside section lines.
3. The distance to the nearest lease or unit boundary line (in footage).
4. If proposed location is located within a prorated or spaced field a certificate of acreage attribution plat must be attached: (CO-7 for oil wells; CG-8 for gas wells).

**KANSAS CORPORATION COMMISSION
OIL & GAS CONSERVATION DIVISION
APPLICATION FOR SURFACE PIT**

Form CDP-1
April 2004
Form must be Typed

Submit in Duplicate

Operator Name: T-N-T Engineering, Inc.		License Number: 33699	
Operator Address: 3711 Maplewood Ave, Suite 201		Wichita Falls TX 76308	
Contact Person: Hal Gill		Phone Number: 940.691.9157 ext 113	
Lease Name & Well No.: L. L. Austin 11		Pit Location (QQQQ): SE SE NW NE Sec. 36 Twp. 12 R. 16 <input type="checkbox"/> East <input checked="" type="checkbox"/> West 1,296 Feet from <input checked="" type="checkbox"/> North / <input type="checkbox"/> South Line of Section 1,329 Feet from <input checked="" type="checkbox"/> East / <input type="checkbox"/> West Line of Section Ellis County	
Type of Pit: <input type="checkbox"/> Emergency Pit <input type="checkbox"/> Burn Pit <input type="checkbox"/> Settling Pit <input checked="" type="checkbox"/> Drilling Pit <input type="checkbox"/> Workover Pit <input type="checkbox"/> Haul-Off Pit <i>(If WP Supply API No. or Year Drilled)</i>		Pit is: <input checked="" type="checkbox"/> Proposed <input type="checkbox"/> Existing If Existing, date constructed: _____ Pit capacity: 2,500 (bbls)	
Is the pit located in a Sensitive Ground Water Area? <input type="checkbox"/> Yes <input checked="" type="checkbox"/> No		Chloride concentration: _____ mg/l <i>(For Emergency Pits and Settling Pits only)</i>	
Is the bottom below ground level? <input checked="" type="checkbox"/> Yes <input type="checkbox"/> No		Artificial Liner? <input type="checkbox"/> Yes <input checked="" type="checkbox"/> No	
		How is the pit lined if a plastic liner is not used? Chemical Mud	
Pit dimensions (all but working pits): 80 Length (feet) 80 Width (feet) <input type="checkbox"/> N/A: Steel Pits Depth from ground level to deepest point: 3 (feet) <input type="checkbox"/> No Pit			
If the pit is lined give a brief description of the liner material, thickness and installation procedure.		Describe procedures for periodic maintenance and determining liner integrity, including any special monitoring.	
Distance to nearest water well within one-mile of pit N/A feet Depth of water well _____ feet		Depth to shallowest fresh water _____ feet. Source of information: <input type="checkbox"/> measured <input type="checkbox"/> well owner <input type="checkbox"/> electric log <input checked="" type="checkbox"/> KDWR	
Emergency, Settling and Burn Pits ONLY: Producing Formation: _____ Number of producing wells on lease: _____ Barrels of fluid produced daily: _____ Does the slope from the tank battery allow all spilled fluids to flow into the pit? <input type="checkbox"/> Yes <input type="checkbox"/> No		Drilling, Workover and Haul-Off Pits ONLY: Type of material utilized in drilling/workover: Chemical Mud Number of working pits to be utilized: 3 Abandonment procedure: Let fluids evaporate, break up and backfill. Cover with top soil. Drill pits must be closed within 365 days of spud date.	
I hereby certify that the above statements are true and correct to the best of my knowledge and belief.		RECEIVED NOV 09 2009 KCC WICHITA	
Date: 9-14-09 Signature of Applicant or Agent: Hal Gill			
KCC OFFICE USE ONLY			
Steel Pit <input type="checkbox"/> RFAC <input type="checkbox"/> RFAS <input type="checkbox"/>			
Date Received: 11/9/09 Permit Number: _____ Permit Date: 11/9/09 Lease Inspection: <input type="checkbox"/> Yes <input checked="" type="checkbox"/> No			

15-051-259 32-00-03

Mail to: KCC - Conservation Division, 130 S. Market - Room 2078, Wichita, Kansas 67202