

15-051-30416-00-00  
WELL PLUGGING RECORD

Give All Information Completely  
Make Required Affidavit  
Mail or Deliver Report to:  
Conservation Division  
State Corporation Commission  
212 No. Market  
Wichita, Kansas

Ellis County. Sec. 1 Twp. 12S Rge. (E) 17(W)

Location as "NE/CNW/SW" or footage from lines NW NE NE

Lease Owner Circle Oil Company, Inc.

Lease Name HALL Well No. 1

Office Address 500 Bitting Building, Wichita, Kansas

Character of Well (completed as Oil, Gas or Dry Hole) Dry Hole

Date well completed January 12, 1967

Application for plugging filed 19

Application for plugging approved 19


Plugging commenced January 12, 1967

Plugging completed January 12, 1967

Reason for abandonment of well or producing formation Dry Hole

If a producing well is abandoned, date of last production 19

Was permission obtained from the Conservation Division or its agents before plugging was commenced? Yes (Leo Massey)

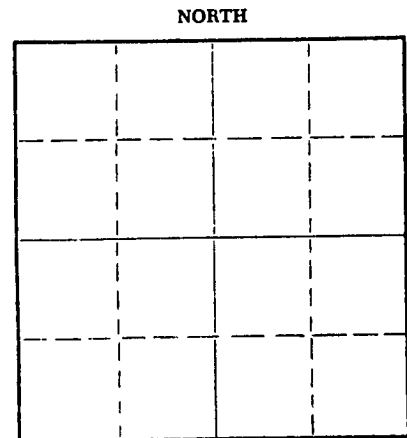

Locate well correctly on above Section Plat

Name of Conservation Agent who supervised plugging of this well

Producing formation \_\_\_\_\_ Depth to top \_\_\_\_\_ Bottom \_\_\_\_\_ Total Depth of Well 3675 Feet

Show depth and thickness of all water, oil and gas formations.

OIL, GAS OR WATER RECORDS

CASING RECORD

FORMATION	CONTENT	FROM	TO	SIZE	PUT IN	PULLED OUT
	Surface	0	306'	8-5/8"	1/3/67	-----
	Casing					

Describe in detail the manner in which the well was plugged, indicating where the mud fluid was placed and the method or methods used in introducing it into the hole. If cement or other plugs were used, state the character of same and depth placed, from \_\_\_\_\_ feet to \_\_\_\_\_ feet for each plug set.

Heavy Mud from Total Depth to 540 Feet; Hull Plug & Plus and 25 sacks Cement thru the Drill Pipe; Mud to 300 Feet; Plug and 20 sacks Cement thru Drill Pipe; Mud to 40 Feet; Hulls and Plug bridged with Kelley and 8 sacks of Cement to Base of Cellar; 2 sacks in Rat Hole. Job completed @ 11 A.M.

1-19-1967  
DIVISION

(If additional description is necessary, use BACK of this sheet)

Name of Plugging Contractor Sage Drilling Co.  
Address 500 Bitting Building, Wichita, Kansas 67202

STATE OF KANSAS, COUNTY OF SEDGWICK, ss.  
Lawrence F. Gray (employee of owner) or (owner or operator) of the above-described well, being first duly sworn on oath, says: That I have knowledge of the facts, statements, and matters herein contained and the log of the above-described well as filed and that the same are true and correct. So help me God.

(Signature) Lawrence F. Gray  
500 Bitting Building, Wichita, Kansas (Address)

SUBSCRIBED AND SWORN TO before me this 17th day of January, 1967  
Louise K. Whitted - Notary Public.

My commission expires November 26, 1970

15-051-30416-00-00

DRILLERS LOG

HALL NO. 1

CASING RECORD: 8-5/8" @ 306'  
w/185 sax Cement

COMPANY: Circle Oil Co.

CONTRACTOR: Sage Drilling Co.

COMMENCED: January 3, 1967

COMPLETED: January 12, 1967

DESCRIPTION: NW NE NE  
Sec. 1-12S-17W  
Ellis County, Kansas

ELEVATION: 2104KB

<u>FORMATION</u>	<u>FROM</u>	<u>TO</u>	<u>REMARKS</u>
Surface Soil, Post Rock	0	306	
Shale	306	665	
Sand	665	715	
Shale	715	840	
Sand	840	896	
Hard Sand	896	914	
Shale	914	965	
Red Bed	965	1290	
Anhydrite	1290	1330	
Shale, Red Bed & Shells	1330	1475	
Shale & Shells	1475	1933	
Lime & Shale	1933	2864	
Shale & Lime	2864	3165	
Lime & Shale	3165	3420	
Lime	3420	3675	

RECEIVED  
STATE REGISTRATION COMMISSION  
JAN 19 1967  
CONSERVATION DIVISION  
WICHITA, KANSAS

I certify that this is a true and correct copy of the above log to the best of my knowledge.

SAGE DRILLING COMPANY, INC.

By Lawrence F. Gray  
Lawrence F. Gray

Subscribed and sworn to before me this 17th day of January, 1967.

Louise K. Whitted  
Louise K. Whitted, Notary Public

My commission expires:  
November 26, 1970.