

STATE OF KANSAS
STATE CORPORATION COMMISSION


Give All Information Completely
Make Required Affidavit
Mail or Deliver Report to:
Conservation Division
State Corporation Commission
800 Bitting Building
Wichita, Kansas

OR

FORMATION PLUGGING RECORD

Strike out upper line
when reporting plug-
ging off formations.

NORTH

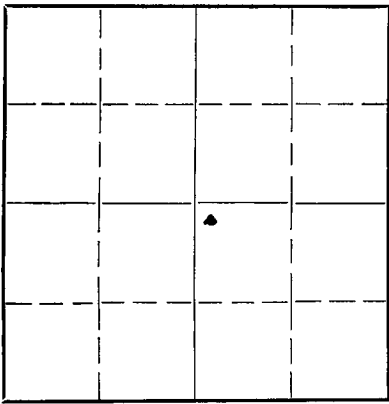

Locate well correctly on above
Section Plat

Ellis County, Sec. 9 Twp. 12 Rge. (E) 17 (W)
Location as "NE $\frac{1}{4}$ NW $\frac{1}{4}$ SW $\frac{1}{4}$ " or footage from lines 330' S. 330' E. of Center NW NW SE
Lease Owner Cities Service Oil Company
Lease Name Rohleder "B"
Office Address Bartlesville, Oklahoma. Well No. B-1
Character of Well (completed as Oil, Gas or Dry Hole) Dry Hole
Date well completed 12-28-43 19
Application for plugging filed 12-28-43 19
Application for plugging approved 12-28-43 19
Plugging commenced 12-28-43 19
Plugging completed 12-29-43 19
Reason for abandonment of well or producing formation Dry

If a producing well is abandoned, date of last production 19
Was permission obtained from the Conservation Division or its agents before plugging was com-
menced? Yes

Name of Conservation Agent who supervised plugging of this well Mr. C.T. Alexander
Producing formation Arbuckle Lime Depth to top 3686' Bottom Total Depth of Well 5716' Feet
Show depth and thickness of all water, oil and gas formations.


OIL, GAS OR WATER RECORDS

CASING RECORD

Formation	Content	From	To	Size	Put In	Pulled Out
Arbuckle Lime	Dry			85/8"	260'	NONE

Describe in detail the manner in which the well was plugged, indicating where the mud fluid was placed and the method or methods used in introducing it into the hold. If cement or other plugs were used, state the character of same and depth placed, from feet to feet for each plug set.

Filled with heavy mud from T.D. 3716' to 260' set plug
dumped 15 sacks cement, mud to 26' dumped 20' cement mud & dirt to surface.

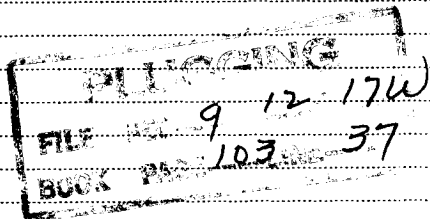

1-23-1944

(If additional description is necessary, use BACK of this sheet)

Correspondence regarding this well should be addressed to Mr. R.C. Hauber
Address Cities Service Oil Co. Great Bend, Kansas.

STATE OF KANSAS, COUNTY OF Ellis Barton, ss.
Mr. J.A. Cleverley (employee of owner) or (owner or operator) of the above-described well,
being first duly sworn on oath, says: That I have knowledge of the facts, statements, and matters herein contained and the log of the above-
described well as filed and that the same are true and correct. So help me God.

(Signature)

Cities Service Oil Co. Russell, Kansas.
(Address)

SUBSCRIBED AND SWORN to before me this 5 day of January, 1944

My Commission Expires Mar. 1, 1944

My commission expires

Notary Public.

AND
PLUGGING RECORD

Mail To: STATE CORPORATION COMMISSION
 Conservation Division
 800 Bitting Building
 Wichita, Kansas

NOTICE: All questions on this form must be answered.

Locate well correctly.

Company Operating..... Cities Service Oil
 Office Address..... Bartlesville, Oklahoma.

County..... Ellis Sec. 9 Twp. 13 Rge. 17
 Farm Name..... Rohleder "B" Well No. 1 Field.....
 Well Location..... 330'S 330'E of center NWNWSE
 Name of Producing Sand..... Arbuckle Lime Total Depth..... 3716'
 Commenced Plugging..... 12-28-43 Finished..... 12-29-43

DAILY AVERAGE PRODUCTION:

Initial Production: Oil..... 0 Gas..... Water.....

Production when Plugged: Oil..... Gas..... Water.....

Estimated Total Remaining Reserves Attributable to Well at Time Abandoned.....

INFORMATION ON MATERIALS RECLAIMED FROM WELL

CASING, TUBING AND ROD DATA

Description	Size	Recovered		Junk		Reusable		Disposition Made Or To Be Made Of Usable Material
		Ft.	Tons	Ft.	Tons	Ft.	Tons	
L.W. Casing	85/8"	260'	left in hole					

SURFACE EQUIPMENT

Quantity	Description	*Condition	Est. Tons	Disposition Made Or To Be Made Of Reclaimed Material

* Usable, Usable with minor repairs, or junk.

Date: 12/31/43 Signed: [Signature] 1-6-1944
 (For Operating Co.—Title)

FILE 9 12 27 40
 103 RE 37

It is very important that all questions on this form be answered, as this Department has been asked by the Petroleum Administration for War to supply data on well abandonments undertaken during the war.

This information is very essential in aiding the war effort; therefore, this Department is requiring this report to be mailed within 5 days after the abandonment of your well.

Company Cities Service Oil Co. Well No. 1 Farm Rohleder "B"
 Location 330' South and 330' East of Center NWNWSE Sec. 9 T. 12 R. 17W
 Elevation 2135 County Ellis State Kansas
 Initial Prod. Dry - Plugged and Abandoned Contractor Hols Drilling Company
 Acid None Drig. Comm. December 4, 1943
 T. D. 3716' Drig. Comp. December 28, 1943

CASING RECORD:

8-5/8" @ 360' con. 100 sx cement

FORMATION RECORD:

rock & shale	0-45
shale & shells	650
sand & iron shells	775
shale & shells	828
shale & lime shells	870
sand, soft	990
shale & shells	1090
shale, red & shells	1214
shale & shells	1350
anhydrite	1395
shale & lime shells	1435
lime	1455
shale & shells	1661
shale & lime shells	1750
salt, shale & shells	1870
shale & lime shells	1960
lime & shale breaks	2097
lime	2150
lime & shale breaks	2290
lime & shale	2342
lime	2410
lime & shale breaks	2617
lime	2843
shale	2918
shale & lime shells	2945
lime	2976
shale & lime shells	3085
lime	3094
shale & lime shells	3102
lime	3126
shale & lime shells	3170
lime	3200
shale & lime shells	3205
lime & iron pyrite	3235
lime	3271
lime & shale breaks	3293
shale & lime shells	3310

lime 3647
 conglomerate 3661
 lime & shale 3669
 conglomerate 3716 T. D.

Top Arbuckle 3686'
 Penetration 30'
 Total Depth 3716'

Halliburton drill stem test
 3686-3702, recovered 90' muddy
 water in 25 minutes.

Hyfo: 1500' 0°
 2000' 0°
 3000' 0°

PLUGGING
 FILE 9-12-17W
 BOOK PAGE 103 LINE 37

15-051-01619-00-00
 123-1944
 JAN 23 1944