


STATE OF KANSAS
 STATE CORPORATION COMMISSION
 200 Colorado Derby Bldg.
 Wichita, Kansas 67202

Form CP-4
 Rev. 12-15-80

15-051-22985-00-00
 WELL PLUGGING RECORD

Give All Information Completely
 Make Required Affidavit

COUNTY Ellis SEC. 9 TWP. 12S RGE. 17 E/W
 Location as in quarters or footage from lines:
990' from South line and 2310' from West line of SW/4

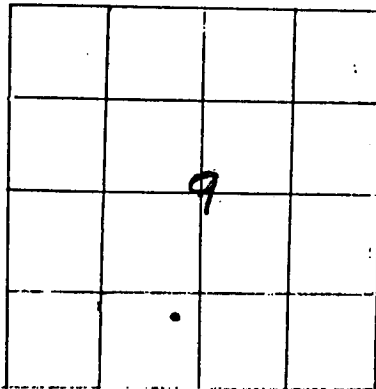

Locate Well
 correctly on above
 Section Platt.

*Lease Owner Zenith Petroleum Corporation Kansas Partnership No. 1
 Lease Name Anita Rohleder Well No. 1
 Office Address 7600 W. Tidwell, Suite 502 Houston, TX 77040
 Character of Well (Completed as Oil, Gas or Dry Hole): Dry Hole
 Date Well Completed _____
 Application for plugging filed June 2, 1982 **
 Plugging commenced 5-18-82
 Plugging completed 5-18-82
 Reason for abandonment of well or producing formation _____
Drilled as a dry hole.

Was permission obtained from the Conservation Division or it's
 Agent's before plugging was commenced? Yes

Name of Conservation Agent who supervised plugging of this well Mr. Gilbert Scheck

Producing formation _____ Depth to top _____ bottom _____ T.D. 3850

Show depth and thickness of all water, oil and gas formations.

OIL, GAS OR WATER RECORDS

Casing Record

Formation	Content	From	To	Size	Put in	Pulled Out
	NONE			8-5/8"	382	None

Describe in detail the manner in which the well was plugged, indicating where the mud
 fluid was placed and the method or methods used in introducing it into the hold. If cement
 or other plugs were used, state the character of same and depth placed, from _____ feet
 to _____ feet for each plug set.

- Set plug #1 in 7-7/8" open hole using 70 sxs 50-50 Pozmix 4% gel, 3% CaCl₂ from
 465 feet to 750 feet.
- Set plug #2 in 8-5/8" casing using 40 sxs 50-50 Pozmix 4% gel, 3% CaCl₂ from
 160 feet to 310 feet
- Set plug #3 in 8-5/8" Casing using 10 sxs 50-50 Pozmix 4% gel, 3% CaCl₂ from
 15 feet to 40 feet
- Cemented rat hole with 10 sxs Pozmix.

RECEIVED
 STATE CORPORATION COMMISSION
 WICHITA, KANSAS

(If additional description is necessary, use BACK of this sheet)

Name of Plugging Contractor Halliburton Services
410 Union Center Bldg., Wichita, Kansas 67202

RECEIVED
 JUN 18 1982
 6-14-1982
 STATE CORPORATION COMMISSION
 WICHITA, KANSAS

STATE OF Texas COUNTY OF Harris, ss.
E.B. Rogers (employee of owner) or (owner or operator) of the

above-described well, being first duly sworn on oath, says: That I have knowledge of the
 facts, statements, and matters herein contained and the log of the above-described well as
 filed and that the same are true and correct. So help me God.

(Signature) E.B. Rogers
7600 W. Tidwell, Suite 502
 (Address)
 Houston, TX 77040

SUBSCRIBED AND SWORN TO before me this 3rd day of June, 19 82

Kathleen Ann Charley
 Notary Public

My Commission expires: April 10, 1984

** Verbal permission granted to plug well by Mr. Gilbert Scheck on 5-18-82.

* Notice of Intention To Drill filed in the name of Zenith Exploration Partnership under
 lease name of Rohleder.