


STATE OF KANSAS
STATE CORPORATION COMMISSION

Give All Information Completely
Make Required Affidavit
Mail or Deliver Report to:
Conservation Division
State Corporation Commission
211 No. Broadway
Wichita, Kansas

15-051-0187-00-00
WELL PLUGGING RECORD

NORTH

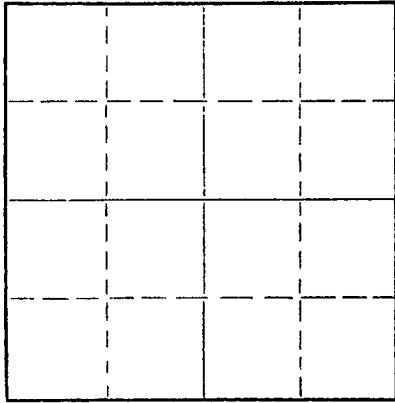

Locate well correctly on above
Section Plat

Ellis County. Sec. 10 Twp. 12 Rge. 17W (E) (W)
Location as "NE/CNW/SW" or footage from lines SW NE NE
Lease Owner Vye-Mallonee
Lease Name Hall "B" Well No. 2
Office Address 820 Union Center, Wichita, Kansas
Character of Well (completed as Oil, Gas or Dry Hole) Dry Hole
Date well completed 3-18 19 58
Application for plugging filed 3-18 19 58
Application for plugging approved 3-18 19 58
Plugging commenced 3-18 19 58
Plugging completed 3-18 19 58
Reason for abandonment of well or producing formation _____

If a producing well is abandoned, date of last production _____ 19____
Was permission obtained from the Conservation Division or its agents before plugging was commenced? yes

Name of Conservation Agent who supervised plugging of this well Eldon Petty
Producing formation _____ Depth to top _____ Bottom _____ Total Depth of Well 3627 Feet
Show depth and thickness of all water, oil and gas formations.

OIL, GAS OR WATER RECORDS

CASING RECORD

FORMATION	CONTENT	FROM	TO	SIZE	PUT IN	PULLED OUT
		0	216	8-5/8	216	None - cement circulated

Describe in detail the manner in which the well was plugged, indicating where the mud fluid was placed and the method or methods used in introducing it into the hole. If cement or other plugs were used, state the character of same and depth placed, from _____ feet to _____ feet for each plug set.

Plug set at 210, 15 sacks cement to 40'.
Plug set at 40', 10 sacks cement to surface.

4-3-1958

(If additional description is necessary, use BACK of this sheet)

Name of Plugging Contractor Mallonee Drilling Company, Inc.
Address 820 Union Center, Wichita, Kansas


STATE OF KANSAS COUNTY OF SEDGWICK, ss.
R. E. Mallonee (employee of owner) or (owner or operator) of the above-described well, being first duly sworn on oath, says: That I have knowledge of the facts, statements, and matters herein contained and the log of the above-described well as filed and that the same are true and correct. So help me God.

(Signature) R. E. Mallonee
820 Union Center, Wichita, Kansas (Address)

SUBSCRIBED AND SWORN TO before me this 31st day of March 19 58

My commission expires December 14, 1961

Martha Gorges Notary Public.

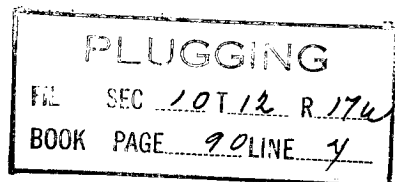

15-051-01187-00-00

DRILLER'S LOG
#2 Well "B"
SW NE NE Section 10-12-17W
Ellis County, Kansas

OWNER: Vye-Mallonee
CONTRACTOR: Mallonee Drilling Company, Inc.

COMMENCED: 2-20-58
COMPLETED: 3-18-58

FROM TO DESCRIPTION

CASING RECORD

0	80	Post rock and shale
80	90	Sand
90	216	Shale and shells
216	535	Shale
535	560	Sand
560	850	Red bed and shale
850	975	Sand
975	1320	Red bed and shale
1320	1365	Anhydrite
1365	1370	Shale
1370	1920	Shale and shells
1920	2045	Lime
2045	2120	Lime and shale
2120	2300	Lime
2300	2370	Lime and shale
2370	2535	Lime
2535	2615	Shale and lime
2615	2805	Lime
2805	2915	Lime and shale
2915	2960	Lime
2960	3065	Lime and shale
3065	3580	Lime
3580	3627	Lime and shale
3627		Rotary Total Depth

11 joints 8-5/8" surface casing set at 216' with 130 sacks common cement, 1 sack CC

Drill Stem Test #1, 3382 - 3418
Open 30 minutes, recovered 27' mud, slight show oil.
BHP 252#

Drill Stem Test #2, 3418 - 3839
Open 30 minutes, recovered 12' mud, specks oil.
BHP 70#

Drill Stem Test #3, 2606 - 3617
Open 40 minutes, recovered 30' mud, slight show oil, show water. BHP 935#

Drill Stem Test #4, 3617 - 3627
Open 2 hours, recovered 250' water. BHP 955#

ELEVATION: 2120 KB

TOPS		
Heebner	3305	-1185
Terente	3328	-1208
Lansing	3354	-1234
Base Kansas City	3581	-1461
Arbuckle	3611	-1491
R.T.D.	3627	-1507

Geologist: Robert D. Gensch

I hereby certify that the above is a true and accurate Driller's Log of the captioned well, to be the best of my knowledge and belief.

R. E. Mallonee
R. E. Mallonee

State of Kansas)
County of Sedgwick) ss

Subscribed and sworn to before me this 31st day of March, 1958.

My commission expires:
December 14, 1961

Marta Gass
Notary Public (Marta Gass)

LOGGING

FILE NO. 10-12-17W

BOOK PAGE 90 LINE 4

4-3-1958