


Give All Information Completely
Make Required Affidavit
Mail or Deliver Report to:
Conservation Division
State Corporation Commission
211 No. Broadway
Wichita, Kansas

WELL PLUGGING RECORD

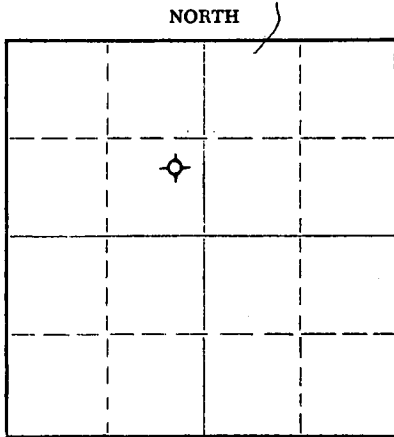

Locate well correctly on above Section Plat

ROOKS County. Sec. 8 Twp. 10 Rge. 20 (E) W(W)
Location as "NE/CNW%SW%" or footage from lines NE SE NW
Lease Owner OKMAR OIL CO. & C-G DRILLING CO.
Lease Name WANKER Well No. 1
Office Address 107 RULE BUILDING
Character of Well (completed as Oil, Gas or Dry Hole) DRY HOLE
Date well completed AUGUST 13 1956
Application for plugging filed AUGUST 13 1956
Application for plugging approved AUGUST 13 1956
Plugging commenced AUGUST 14 1956
Plugging completed AUGUST 14 1956
Reason for abandonment of well or producing formation TOO LOW STRUCTUALLY

If a producing well is abandoned, date of last production _____ 19____
Was permission obtained from the Conservation Division or its agents before plugging was commenced? YES

Name of Conservation Agent who supervised plugging of this well ELDON PETTY, HAYS, KANSAS
Producing formation _____ Depth to top _____ Bottom _____ Total Depth of Well 3970 Feet
Show depth and thickness of all water, oil and gas formations.

OIL, GAS OR WATER RECORDS

CASING RECORD

| FORMATION | CONTENT | FROM | TO | SIZE | PUT IN | PULLED OUT |
|-----------|---------|------|----|--------|--------|------------|
| | | | | 8-5/8" | 208' | none |
| | | | | | | |
| | | | | | | |
| | | | | | | |
| | | | | | | |
| | | | | | | |
| | | | | | | |

Describe in detail the manner in which the well was plugged, indicating where the mud fluid was placed and the method or methods used in introducing it into the hole. If cement or other plugs were used, state the character of same and depth placed, from _____ feet to _____ feet for each plug set.

FILLED HOLE WITH HEAVY MUD TO 179'. Set PLUG. PUT IN 1/2 SACK HULLS AND 15 SACKS CEMENT. FILLED WITH HEAVY MUD UP TO 40'. SET PLUG. FILLED TO TOP WITH 1/2 SACK HULLS AND 10 SACKS CEMENT.

(If additional description is necessary, use BACK of this sheet)

Name of Plugging Contractor C-G DRILLING CO.
Address 107 RULE BLDG., WICHITA, KANSAS

STATE OF KANSAS, COUNTY OF SEDGWICK, ss.
Jay H. Galloway (employee of owner) or (owner or operator) of the above-described well, being first duly sworn on oath, says: That I have knowledge of the facts, statements, and matters herein contained and the log of the above-described well as filed and that the same are true and correct. So help me God.

(Signature) Jay H. Galloway
Jay H. Galloway
107 Rule Bldg.
(Address)

SUBSCRIBED AND SWORN to before me this 20th day of August, 1956.

Vicky Jacobs
Vicky Jacobs
Notary Public.

My commission expires May 20, 1959

PLUGGING
FILE SEC. 8 T. 10 R. 20W
BOOK PAGE 90 LINE 23

8-21-56

15-163-00987-0000

CONTRACTOR'S WELL LOG

OPERATOR OKMAR OIL COMPANY & C-G DRILLING CO. WELL NAME WANKER #1

LOCATION NE/4 SE/4 NW/4 SECTION 8-10-20W RIG NO. 1

COUNTY ROOKS STATE KANSAS

COMMENCEMENT DATE AUGUST 5, 1956 COMPLETION DATE AUGUST 13, 1956

LOG OF WELL

All measurements taken from the top of rotary bushing.

| FROM | TO | FORMATION | DEVIATION FROM VERTICAL | REMARKS |
|------|------|------------------|-------------------------|---------|
| 0 | 203 | Surface Soil | | |
| 203 | 1000 | Sand-Shale | | |
| 1000 | 1255 | Shale | | |
| 1255 | 1480 | Sand | | |
| 1480 | 1774 | Red Bed | | |
| 1774 | 1814 | Anhydrite | | |
| 1814 | 2265 | Shale-Shells | | |
| 2265 | 2445 | Lime-Shale | | |
| 2445 | 2580 | Lime-Shale | 0° - 2500 | |
| 2580 | 2690 | Lime-Shale | | |
| 2690 | 2795 | Lime-Shale | 0° - 2750 | |
| 2795 | 2960 | Lime-Shale | | |
| 2960 | 3040 | Lime-Shale | 0° - 3000 | |
| 3040 | 3155 | Lime-Shale | | |
| 3155 | 3275 | Lime-Shale | 0° - 3250 | |
| 3275 | 3380 | Lime-Shale | | |
| 3380 | 3471 | Lime-Shale | | |
| 3471 | 3535 | Lime-Shale | | |
| 3535 | 3590 | Lime-Shale | 0° - 3500 | |
| 3590 | 3637 | Lime-Shale | | |
| 3637 | 3680 | Lime-Shale | | |
| 3680 | 3730 | Lime-Shale | | |
| 3730 | 3785 | Lime-Shale | 0° - 3750 | |
| 3785 | 3836 | Lime-Shale | | |
| 3836 | 3881 | Conglomerate | | |
| 3881 | 3945 | Lime-Shale | | |
| 3945 | 3970 | Lime-Shale Chert | | |

CASING LEFT IN HOLE AFTER COMPLETION

208' of 8-5/8" OD Surface Casing.

STATE OF KANSAS, COUNTY OF SEDGWICK) SS.

The undersigned hereby certifies that to the best of his knowledge and belief, the above facts are true and correct.

C-G DRILLING CO.

By Jay H. Galloway
Jay H. Galloway

Subscribed and sworn to before me this 20th day of August, 1956.

My commission expires;
May 20, 1959

Vicky Jacobs
Vicky Jacobs, Notary Public

PLUGGING
FILE SEC 8 T 10 R 20W
BOOK PAGE 90 LINE 23