


15-163-00600-0000

STATE OF KANSAS  
STATE CORPORATION COMMISSION

Give All Information Completely  
Make Required Affidavit  
Mail or Deliver Report to:  
Conservation Division  
State Corporation Commission  
800 Bittling Building  
Wichita, Kansas

WELL PLUGGING RECORD

NORTH

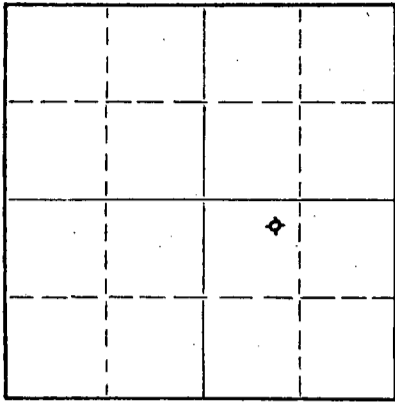

Locate well correctly on above  
Section Plat

Rooks County. Sec. 8 Twp. 10 Rge. 20 (E) W (W)

Location as "NE/CNW%SW%" or footage from lines NE NW SE

Lease Owner D. G. Hansen

Lease Name Williams "B" Well No. 2

Office Address Logan, Kansas

Character of Well (completed as Oil, Gas or Dry Hole) Dry Hole

Date well completed 9-29 1954

Application for plugging filed 9-28 1954

Application for plugging approved 9-28 1954

Plugging commenced 9-29 1954

Plugging completed 9-29 1954

Reason for abandonment of well or producing formation Too low structurally

If a producing well is abandoned, date of last production -- 19--

Was permission obtained from the Conservation Division or its agents before plugging was commenced? Yes

Name of Conservation Agent who supervised plugging of this well Eldon Petty, Hays, Kansas

Producing formation -- Depth to top -- Bottom -- Total Depth of Well 3916 Feet

Show depth and thickness of all water, oil and gas formations.

OIL, GAS OR WATER RECORDS

CASING RECORD

FORMATION	CONTENT	FROM	TO	SIZE	PUT IN	PULLED OUT
				8-5/8	175.64	None

Describe in detail the manner in which the well was plugged, indicating where the mud fluid was placed and the method or methods used in introducing it into the hole. If cement or other plugs were used, state the character of same and depth placed, from -- feet to -- feet for each plug set.

Filled hole with mud to 170'; set plug; 1/2 sack hulls, 15 sacks cement. Filled hole w/ mud to 40'; set plug then filled to top w/ 10 sacks cement 1/2 sack hulls.

RECEIVED  
STATE CORPORATION COMMISSION  
10-2-54  
OCT - 2 1954

CONSERVATION DIVISION  
Wichita, Kansas

(If additional description is necessary, use BACK of this sheet)

Name of Plugging Contractor C-G DRILLING CO.

Address 107 Rule Building, Wichita, Kansas

STATE OF KANSAS, COUNTY OF SEDGWICK, ss.  
Vicky Jacobs (employee of owner) or (~~owner~~) of the above-described

well, being first duly sworn on oath, says: That I have knowledge of the facts, statements, and matters herein contained and the log of the above-described well as filed and that the same are true and correct. So help me God.

(Signature) Vicky Jacobs Office Manager  
107 Rule Building, Wichita, Kansas  
(Address)

SUBSCRIBED-AND SWORN to before me this 1st day of October, 1954

Barbara Donaldson  
Notary Public.

My commission expires June 17, 1957

PLUGGING  
FILE SEC 8 T 16 Row  
PAGE 67 LINE 42

15-163-00660-0000

CONTRACTOR'S WELL LOG

OPERATOR D. G. Hansen FARM NAME Williams "B" #2  
LOCATION NE NW SE, Sec. 8-10-20W  
POOL NAME \_\_\_\_\_ COUNTY Rooks STATE Kansas  
COMMENCEMENT DATE September 22, 1954 COMPLETION DATE September 29, 1954

LOG OF WELL

Elevation: 2266 R.B.  
All measurements from the top of rotary bushing.

FROM	TO	FORMATION	DEVIATION FROM VERTICAL	REMARKS:
0	175	Shale		
175	1235	Shale		
1235	1300	Sand		
1300	1480	Sand		
1480	1758	Red Bed	0° - 1500'	
1758	1798	Anhydrite		
1798	1880	Shale-Shells		
1880	2300	Shale-Shells	0° - 2000'	
2300	2500	Lime-Shale	0° - 2500'	
2500	2660	Lime-Shale		
2660	2890	Lime-Shale		
2890	3010	Lime-Shale	0° - 3000'	
3010	3180	Lime-Shale		
3180	3350	Lime-Shale		
3350	3440	Lime-Shale		
3440	3525	Lime-Shale	0° - 3500'	
3525	3595	Lime-Shale		
3595	3655	Lime-Shale		
3655	3710	Lime-Shale		
3710	3775	Lime-Shale		
3775	3835	Lime-Shale		
3835	3916	Lime-Shale		

CASING LEFT IN HOLE AFTER COMPLETION

Ran 175.64' (6 jts) of 8-5/8" Surface Casing.

STATE OF KANSAS, COUNTY OF SEDGWICK ) ss.

The undersigned certifies that to the best of her knowledge and belief, the above facts are true and correct.

C-G DRILLING CO.

By Wally Jacobs  
Office Manager

Subscribed and sworn to before me this 1st day of October, 1954.

My commission expires: June 17, 1957

Barbara Donaldson

RECORDED  
STATE OF KANSAS  
OCT 29 1954  
CONSERVATION DIVISION  
Wichita, Kansas

**PLUGGING**  
FILE DEC 8 10 20W  
67 42