


15-163-03314-0000

STATE OF KANSAS
STATE CORPORATION COMMISSION

WELL PLUGGING RECORD

Give All Information Completely
Make Required Affidavit
Mail or Deliver Report to:
Conservation Division
State Corporation Commission
800 Bittling Building
Wichita, Kansas

Rooks County. Sec. 8 Twp. 10S Rge. (E) 20 (W)
Location as "NE/CNW $\frac{1}{4}$ SW $\frac{1}{4}$ " or footage from lines SE $\frac{1}{4}$ -SE $\frac{1}{4}$ -SE $\frac{1}{4}$
Lease Owner Champlin Refining Company
Lease Name Ed Williams Well No. 1
Office Address Dr. #552, Enid, Oklahoma.
Character of Well (completed as Oil, Gas or Dry Hole) Dry hole
Date well completed May 22, 1950
Application for plugging filed May 22, 1950
Application for plugging approved May 22, 1950
Plugging commenced May 22, 1950
Plugging completed May 22, 1950
Reason for abandonment of well or producing formation

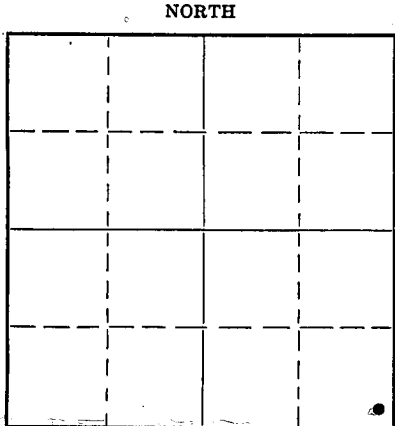

Locate well correctly on above
Section Plat

If a producing well is abandoned, date of last production 19...
Was permission obtained from the Conservation Division or its agents before plugging was commenced? Yes

Name of Conservation Agent who supervised plugging of this well Mr. Eldon Petty
Producing formation Depth to top Bottom Total Depth of Well 3895' Feet
Show depth and thickness of all water, oil and gas formations.

OIL, GAS OR WATER RECORDS

CASING RECORD

Formation	Content	From	To	Size	Put In	Pulled Out
				8 5/8"	255'	None

Describe in detail the manner in which the well was plugged, indicating where the mud fluid was placed and the method or methods used in introducing it into the hole. If cement or other plugs were used, state the character of same and depth placed, from...feet to...feet for each plug set.

Filled hole with heavy mud from 3895' T. D. to 254' and set cement plug using 15 sacks cement then filled hole with heavy mud from top of cement plug to 30' and set cement plug in top using 10sacks of cement from 30' to bottom of celler.

(If additional description is necessary, use BACK of this sheet)


Correspondence regarding this well should be addressed to Champlin Refining Company
Address Dr. #552, Enid, Oklahoma.

STATE OF Kansas, COUNTY OF Barton, ss.
S. P. Hall (employee of owner) or (owner/operatory) of the above-described well,

being first duly sworn on oath, says: That I have knowledge of the facts, statements, and matters herein contained and the log of the above-described well as filed and that the same are true and correct. So help me God.

(Signature) S. P. Hall
P. O. Box 167, Ellinwood, Kansas. (Address)

Subscribed and sworn to before me this 27th day of May 19 50
October 24, 1951
My commission expires

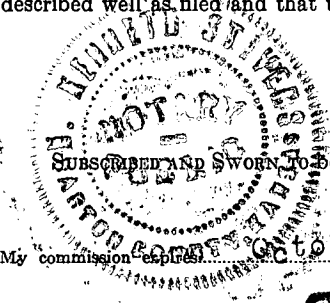

Kenneth Steven
Notary Public.

PLUGGING
FILE SEC-8 T 10 R 2024
BOOK PAGE 7 LINE 43

15-163-03314-0000

CHAMPLIN REFINING COMPANY

Ed Williams #1

330' from the East line and 330' from the south line of the Southeast quarter of Section 8-10s-20w, Rooks County, Kansas.

FORMATION LOG

- 0' - 255' Sand and shale
- 255' - 940' Sand and shale
- 940' - 1575' shale, sand and shells
- 1575' - 1800' Red Bed, Anhydrite and shale
- 1800' - 2190' Shales
- 2190' - 2260' shale and lime
- 2260' - 2390' Lime and shale
- 2390' - 2515' shale and lime
- 2515' - 2615' shale and lime
- 2615' - 2700' Lime and shale
- 2700' - 2810' Lime and sand
- 2810' - 2915' Lime and shale
- 2915' - 3010' Shale and lime
- 3010' - 3125' shale
- 3125' - 3215' shale
- 3215' - 3305' Shale and lime
- 3305' - 3405' Lime
- 3405' - 3475' Lime
- 3475' - 3525' Lime
- 3525' - 3585' Lime
- 3585' - 3640' Lime
- 3640' - 3715' Lime
- 3715' - 3780' Lime
- 3780' - 3835' Lime and shale
- 3835' - 3870' shale and lime
- 3870' - 3895' Lime
- 3895' Total Depth

PLUGGING
 FILE SEC 8 T10R20W
 BOOK PAGE 7 LINE 43