


15-163-03395-0000

STATE OF KANSAS
STATE CORPORATION COMMISSION
Give All Information Completely
Make Required Affidavit
Mail or Deliver Report to:
Conservation Division
State Corporation Commission
800 Bittling Building
Wichita, Kansas

WELL PLUGGING RECORD

Rooks County, Sec. 8 Twp. 10 Rge. 20 (W)
Location as "NE/CNW $\frac{1}{4}$ SW $\frac{1}{4}$ " or footage from lines C N/2 NW NW
Lease Owner Cooperative Refinery Association
Lease Name Wanker "A" Well No. 2
Office Address Box 765 - Great Bend, Kansas
Character of Well (completed as Oil, Gas or Dry Hole) Dry Hole
Date well completed March 4 19 52
Application for plugging filed March 4 19 52
Application for plugging approved March 10 19 52
Plugging commenced March 4 19 52
Plugging completed March 5 19 52
Reason for abandonment of well or producing formation Dry Hole

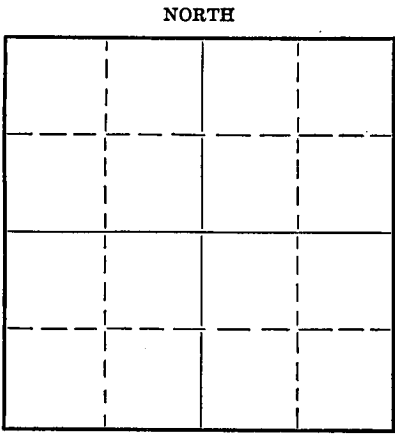

Locate well correctly on above Section Plat

If a producing well is abandoned, date of last production Non Productive 19...
Was permission obtained from the Conservation Division or its agents before plugging was commenced? Yes

Name of Conservation Agent who supervised plugging of this well Eldon Petty
Producing formation Non Productive Depth to top Bottom 3920 Total Depth of Well 3920 Feet
Show depth and thickness of all water, oil and gas formations.

OIL, GAS OR WATER RECORDS

CASING RECORD

Formation	Content	From	To	Size	Put In	Pulled Out
Surface				8 5/8"	209'	None

Describe in detail the manner in which the well was plugged, indicating where the mud fluid was placed and the method or methods used in introducing it into the hole. If cement or other plugs were used, state the character of same and depth placed, from feet to feet for each plug set.

Set plug at 200' with $\frac{1}{2}$ sack of hulls and 15 sacks cement. Plug at 40' with $\frac{1}{2}$ sack hulls and 10 sacks cement.

RECEIVED
3-18-52

(If additional description is necessary, use BACK of this sheet)

Correspondence regarding this well should be addressed to Cooperative Refinery Assn.
Address Box 765 - Great Bend

STATE OF Kansas, COUNTY OF Barton, ss.
L. M. Collins (employee of owner) or (owner or operator) of the above-described well, being first duly sworn on oath, says: That I have knowledge of the facts, statements, and matters herein contained and the log of the above-described well as filed and that the same are true and correct. So help me God.

(Signature) L M Collins
Box 765 - Great Bend, Kansas (Address)

SUBSCRIBED AND SWORN to before me this 13 day of March, 19 52

Arthur J. Robinson Notary Public.

My commission expires February 14, 1955

28-5091-s 8-50-10M

PLUGGING
FILE SEC 8 T 10 R 20W
PAGE 149 LINE 19

Wanker "A" #2
 OWNER: Cooperative Refinery Association
 Contractor: Champlin Refining Co.
 Commenced: 2-17-52
 Completed: 3-4-52

C N/2 NW NW
 8-10S-20W, Rooks county, Kansas
 Casing:
 8 5/8" at 209' with 150 sacks

Elevation: 2265'

<u>Formation</u>	<u>From</u>	<u>To</u>	<u>Geological Tops D. F.</u>
Clay & Sand	0	60	Anhydrite 1757 (/508)
Shale & Shells	60	312	Heebner 3508 (-1243)
Shale	312	370	Lansing-Kansas C. 3552 (-1287)
Shale & Shells	370	1760	Conglomerate 3803 (-1538)
Anhydrite	1760	1905	Rotary Total Depth 3917 (-1652)
Shale & Shells	1905	2360	
Lime & Shale	2360	2500	
Shale & Shells	2500	2605	
Shale	2605	2660	
Lime & Shale	2660	3000	
Shale	3000	3080	
Lime & Shale	3080	3511	
Lime	3511	3843	
Conglomerate	3843	3907	
Total Depth		3920'	

STATE OF KANSAS)
 COUNTY OF BARTON)

I hereby certify that the above is a true and correct copy of the log on the Wanker "A" #2, well located C N/2 NW NW, Section 8-10S-20W, Rooks County Kansas.

L. M. Collins

Subscribed and sworn to before me this
17th day of March, 1952.

Arthur J. Johnson

My Commission Expires: February 14, 1955



LOGGING
 FILE SEC 6 T 10 R 20
 BOOK PAGE 149 LINE 19