

WELL PLUGGING RECORD

Give All Information Completely  
Make Required Affidavit  
Mail or Deliver Report to:  
Conservation Division  
State Corporation Commission  
800 Bitting Building  
Wichita, Kansas

Rooks

County. Sec. 8 Twp. 10 Rge. 20 (E) W (W)

Location as "NE/CNW/SW" or footage from lines NW SE NE

Lease Owner D. G. Hansen

Lease Name Oesterreich Well No. 2

Office Address Logan, Kansas

Character of Well (completed as Oil, Gas or Dry Hole) Dry Hole

Date well completed 10-6 1954

Application for plugging filed 10-6 1954

Application for plugging approved 10-6 1954


Plugging commenced 10-6 1954

Plugging completed 10-6 1954

Reason for abandonment of well or producing formation Too low structurally

If a producing well is abandoned, date of last production -- 19---

Was permission obtained from the Conservation Division or its agents before plugging was commenced? Yes

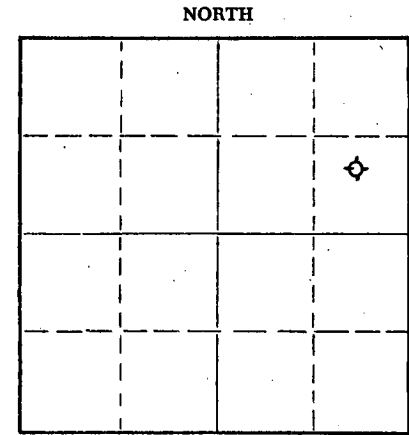

Locate well correctly on above Section Plat

Name of Conservation Agent who supervised plugging of this well Eldon Petty, Hays, Kansas

Producing formation -- Depth to top -- Bottom -- Total Depth of Well 3910 Feet

Show depth and thickness of all water, oil and gas formations.

OIL, GAS OR WATER RECORDS

CASING RECORD

FORMATION	CONTENT	FROM	TO	SIZE	PUT IN	PULLED OUT
				8-5/8"	169.78	

Describe in detail the manner in which the well was plugged, indicating where the mud fluid was placed and the method or methods used in introducing it into the hole. If cement or other plugs were used, state the character of same and depth placed, from \_\_\_\_\_ feet to \_\_\_\_\_ feet for each plug set.

Filled hole with mud to 165'; set plug; 1/2 sack hulls, 15 sacks cement. Filled hole with mud to 40'; set plug then filled to top with 10 sacks cement and 1/2 sack hulls.

10-9-54  
STATE CORPORATION COMMISSION  
CONSERVATION DIVISION  
WICHITA, KANSAS

(If additional description is necessary, use BACK of this sheet)

Name of Plugging Contractor C-G DRILLING CO.

Address 107 Rule Building, Wichita, Kansas

STATE OF KANSAS, COUNTY OF SEDGWICK, ss.  
Vicky Jacobs (employee of owner) or (~~owner or operator~~) of the above-described

well, being first duly sworn on oath, says: That I have knowledge of the facts, statements, and matters herein contained and the log of the above-described well as filed and that the same are true and correct. So help me God.

(Signature) Vicky Jacobs Office Manager  
107 Rule Building, Wichita, Kansas  
(Address)

SUBSCRIBED AND SWORN to before me this 8th day of October, 1954

My commission expires June 17, 1957

Barbara Donaldson  
Notary Public.

**PLUGGING**  
FILE SEC 8 TWP 10 R 20W  
BOOK PAGE 69 LINE 41

15-163-00577-0000

CONTRACTOR'S WELL LOG

OPERATOR D. G. Hansen FARM NAME Oesterreich #2  
 LOCATION NW SE NE, Sec. 8-10-20W  
 POOL NAME \_\_\_\_\_ COUNTY Rooks STATE Kansas  
 COMMENCEMENT DATE September 29 COMPLETION DATE October 6, 1954

LOG OF WELL

Elevation: 2262 R.B.  
 All measurement from the top of rotary bushing.

FROM	TO	FORMATION	DEVIATION FROM VERTICAL	REMARKS:
0	170	Shale		
170	850	Shale		
850	1280	Shale		
1280	1490	Sand		
1490	1700	Red Bed	0° - 1500'	
1700	1763	Red Bed		
1763	1801	Anhydrite		
1801	2175	Shale-Shells	0° - 2000'	
2175	2420	Lime-Shale		
2420	2610	Lime-Shale	0° - 2500'	
2610	2800	Lime-Shale		
2800	2960	Lime-Shale		
2960	3110	Lime-Shale	0° - 3000'	
3110	3260	Lime-Shale		
3260	3380	Lime-Shale		
3380	3460	Lime-Shale		
3460	3550	Lime-Shale	0° - 3500'	
3550	3621	Lime-Shale		
3621	3680	Lime-Shale		
3680	3755	Lime-Shale		
3755	3825	Lime-Shale		
3825	3880	Lime-Shale-Chert		
3880	3910	Lime-Shale		

CASING LEFT IN HOLE AFTER COMPLETION

Ran 169.78' (6 jts) of 8-5/8" Surface Casing.

STATE OF KANSAS }  
 COUNTY OF SEDGWICK } ss.

RECEIVED  
 OCT 10 1954  
 INSPECTION DIVISION  
 (Ogden, Kansas)

The undersigned certifies that to the best of her knowledge and belief, the above facts are true and correct.


C-G DRILLING CO.

By Wicky Jacobs  
 Office Manager

Subscribed and sworn to before me this 8th day of October, 1954.

My commission expires: June 17, 1957

Barbara Donaldson  
 Notary Public

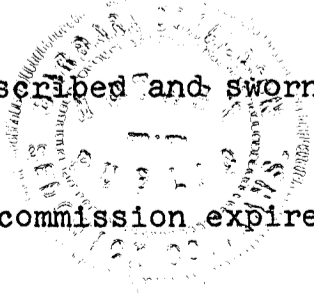

**PLUGGING**  
 FILE SEC 8 T 10 R 20W  
 BOOK PAGE 69 LINE 41