


15-163-03317-0000

STATE OF KANSAS  
STATE CORPORATION COMMISSION

WELL PLUGGING RECORD

Give All Information Completely  
Make Required Affidavit  
Mail or Deliver Report to:  
Conservation Division  
State Corporation Commission  
800 Bitting Building  
Wichita, Kansas

Rooks County, Sec. 9 Twp. 10S Rge. 20 ~~20~~ (W)  
Location as "NE/CNW $\frac{1}{4}$ SW $\frac{1}{4}$ " or footage from lines SW $\frac{1}{4}$  NE $\frac{1}{4}$  SW $\frac{1}{4}$   
Lease Owner Heathman Drilling Co., Inc.  
Lease Name RODE Well No. 1  
Office Address 509 Orpheum Bldg., Wichita, Kansas  
Character of Well (completed as Oil, Gas or Dry Hole) dry hole  
Date well completed 4-15- 1950  
Application for plugging filed 4-15- 1950  
Application for plugging approved 4-15- 1950  
Plugging commenced 4-15- 1950  
Plugging completed 4-15- 1950  
Reason for abandonment of well or producing formation

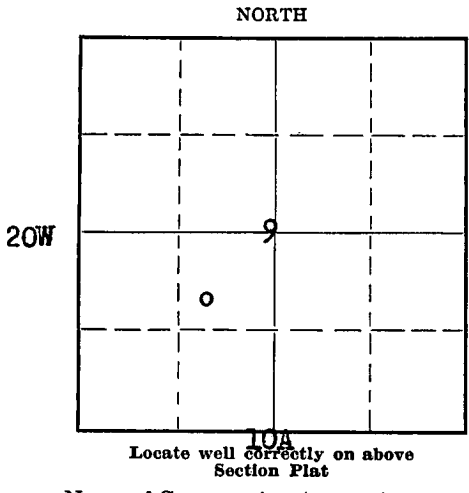

If a producing well is abandoned, date of last production 19  
Was permission obtained from the Conservation Division or its agents before plugging was commenced? yes

Name of Conservation Agent who supervised plugging of this well Eldon Petty, Hays, Kansas  
Producing formation none - Depth to top Bottom Total Depth of Well 3890 Feet  
Show depth and thickness of all water, oil and gas formations.

OIL, GAS OR WATER RECORDS

CASING RECORD

Formation	Content	From	To	Size	Put In	Pulled Out
none				8-5/8 "	128'	none
				surface csg.		
				cemented w/100 sacks		cement and
				1 sack Cal. Chloride		

Describe in detail the manner in which the well was plugged, indicating where the mud fluid was placed and the method or methods used in introducing it into the hole. If cement or other plugs were used, state the character of same and depth placed, from feet to feet for each plug set.

Filled hole with heavy mud; set bottom hole plug w/30 sacks cement @ 100'; which filled hope to within 5' of top of hole. Plugging completed 10 p.m. 4-15-50

4-21-50

(If additional description is necessary, use BACK of this sheet)  
Correspondence regarding this well should be addressed to Heathman Drilling Co., Inc.  
Address 509 Orpheum Bldg., Wichita, Kansas

STATE OF Kansas, COUNTY OF Sedgwick, ss.  
Robert F. Walters (employee of owner) of the above-described well,  
being first duly sworn on oath, says: That I have knowledge of the facts, statements, and matters herein contained and the log of the above-described well as filed and that the same are true and correct. So help me God.


(Signature) Robert F. Walters  
509 Orpheum Bldg., Wichita, Kansas  
(Address)

SUBSCRIBED AND SWORN to before me this 19th day of April, 19 50

My commission expires June 28, 1952.

D. Marjorie Matt  
Notary Public.

22-7377-8 4-49-10M

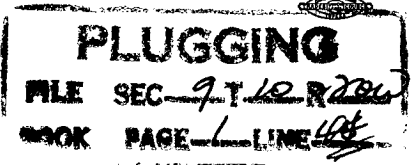

RODE WELL # 1

Location:	SW/4 NE/4 SE/4 Sec. 9-10E-20N Rooks County, Kansas	Date Spudded:	4-5-50
Operator:	Heathman Drilling Co., Inc.	Rotary Completion:	4-15-50
Contractor:	Heathman Drilling Co., Inc.	Total Depth:	3890
Surface Casing:	4 jts. 8-5/8" (128.85') cemented @ 128' w/100 sacks cement and 1 sack Cal. Chloride.	Elevation:	2230 Gr. 2233 DF 2235 KB
Oil String:	none run - Plugged and abandoned 4-15-50		

TOPS (KB)

Anhydrite	1722 (+ 513)
Topeka	3274 (-1039)
Hebner	3479 (-1244)
Lansing	3519 (-1204)
Base K.C.	3743 (-1508)
Shale Conglomerate	3781 (-1546)
Chert Conglomerate	3820 (-1505)
Reworked Simpson	3836 (-1601)
Arbuckle	3843 (-1608)
Total Depth	3890 (-1655)

LOG

(Figures indicate bottom of formation)

Sand shale	0 to 130
Shale	522
Shale	840
Sand and shale	1184
Shale	1195
Sand	1435
Shale and shells	1721
Anhydrite	1755
Shale shells	2485
Shale and lime	3033
Shale	3198
Shale and lime	3288
Lime	3419
Lime - shale	3472
Lime	3701
Lime - shale	3760
Lime shale and Conglomerate	3839
Lime and shale	3884
Lime	3890
Total Depth	3890'

The undersigned, Heathman Drilling Co., Inc., hereby certifies that the above log is a true and correct log of the formations encountered in drilling the above noted well as reflected by the Daily Drilling Reports.

HEATHMAN DRILLING CO., INC.

BY: Robert F. Walters

Subscribed and sworn to before  
me this 17th day of April 1950

D. Marjorie Mott  
Notary Public

**PLUGGING**  
FILE SEC 9 - T 10 R 000  
BOOK PAGE 1 LINE 45

my commission expires: June 28, 1952.