

15-163-03320-0000

WELL PLUGGING RECORD

STATE OF KANSAS STATE CORPORATION COMMISSION


Give All Information Completely Make Required Affidavit Mail or Deliver Report to: Conservation Division State Corporation Commission 800 Blitting Building Wichita, Kansas

OR

Strike out upper line when reporting plugging of formations.

FORMATION PLUGGING RECORD

ROOKS County. Sec. 9 Twp. 10S Rge. 20(W) Location as "NE 1/4 NW 1/4 SW 1/4" or footage from lines. NE 1/4 SE 1/4 NW 1/4 Lease Owner: Heathman Drilling Co., Inc., et al Lease Name: SELINA-VEATCH "A" Well No. 1 Office Address: 509 Orpheum Bldg., Wichita, Kansas Character of Well (completed as Oil, Gas or Dry Hole): location abandoned Date well completed: 2-3-1950 Application for plugging filed: 2-3-1950 Application for plugging approved: 2-3-1950 Plugging commenced: 2-3-1950 Plugging completed: 2-3-1950 Reason for abandonment of well or producing formation: abandoned location

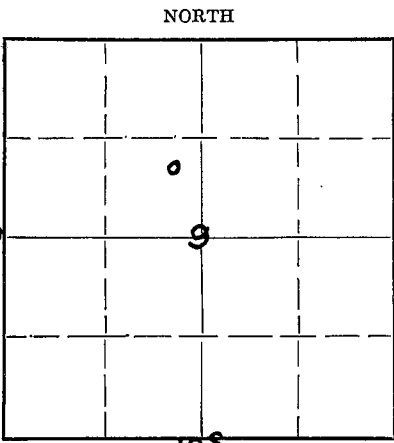

Locate well correctly on above Section Plat

If a producing well is abandoned, date of last production: 19. Was permission obtained from the Conservation Division or its agents before plugging was commenced? yes

Name of Conservation Agent who supervised plugging of this well: Eldon Petty, Box 326, Hays, Kansas Producing formation: location abandoned Depth to top: -- Bottom: -0 Total Depth of Well: 1711 Feet Show depth and thickness of all water, oil and gas formations.

OIL, GAS OR WATER RECORDS

CASING RECORD

Table with 6 columns: Formation, Content, From, To, Size, Put In, Pulled Out. Row 1: location abandoned, 8-5/8" surface cement @ 121' w/85 sacks cement and 1 sack Calcium Chloride, none.

Describe in detail the manner in which the well was plugged, indicating where the mud fluid was placed and the method or methods used in introducing it into the hole. If cement or other plugs were used, state the character of same and depth placed, from feet to feet for each plug set.

Filled hole with heavy mud; set bottom hole plug @ 124' cemented w/15 sacks cement; set plug at top @ 30' w/10 sacks.

3-16-50

(If additional description is necessary, use BACK of this sheet)

Correspondence regarding this well should be addressed to: Heathman Drilling Co., Inc. Address: 509 Orpheum Bldg., Wichita, Kansas

STATE OF Kansas COUNTY OF Sedgwick, ss. Robert F. Walters (employee of owner)

being first duly sworn on oath, says: That I have knowledge of the facts, statements, and matters herein contained and the log of the above-described well as filed and that the same are true and correct. So help me God.


HEATHMAN DRILLING CO., INC. by: Robert F. Walters (Signature)

509 Orpheum Bldg., Wichita 2, Kansas (Address)

SUBSCRIBED AND SWORN to before me this 6th day of February, 19 50

My commission expires June 28, 1952

d. Marjorie Matt Notary Public.

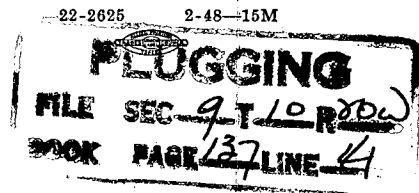

BELINA-VEATCH "A" # 1

Location:	NE/4 SE/4 NW/4 Sec. 9-10S-20W Rooks County, Kansas	Spudded: 1-31-50
Operator:	Heathman Drilling Co., Inc.	Abandoned: 2-3-50
Contractor:	Heathman Drilling Co., Inc.	Total Depth: 1711'
Surface Casing:	4 jts. (126.60') 8-5/8" 2 1/2" 8 rd. thd. cemented @ 121' w/35 sacks cement and 1 sack C.C.	Elevation: 2173' DF; 2170' Gr. 2175' KB
Oil String:	None run - location temporarily abandoned	

TOPS (KB)

Anhydrite 1669 (4506)

LOG

(Figures indicate bottom of formation)

Sand and shale	0 to 60
Sand and shale (surface)	137
Shale	540
Shale and shells	1150
Sand	1180
Sand	1400
Sand, red bed	1669
Anhydrite	1695
Anhydrite	1711'
Total Depth (temporarily abd.)	1711'

The undersigned, Heathman Drilling Co., Inc., hereby certifies that the above log is a true and correct log of the formations encountered in drilling the above named well to total depth of 1711' where it was temporarily abandoned, as reflected by the Daily Drilling Reports.

HEATHMAN DRILLING CO., INC.

BY: H. D. Shreve
H. D. Shreve

Subscribed and sworn to before
me this 6th day of February, 1950.

D. Marjorie Matt
Notary Public

My commission expires: June 28, 1952.

PLUGGING

FILE SEC 9 T 10 S 20 W
BOOK PAGE 137 LINE 41

MAR 16 1950