


15-163-03321-0000

STATE OF KANSAS  
STATE CORPORATION COMMISSION

WELL PLUGGING RECORD

Give All Information Completely  
Make Required Affidavit  
Mail or Deliver Report to:  
Conservation Division  
State Corporation Commission  
800 Bittling Building  
Wichita, Kansas

NORTH

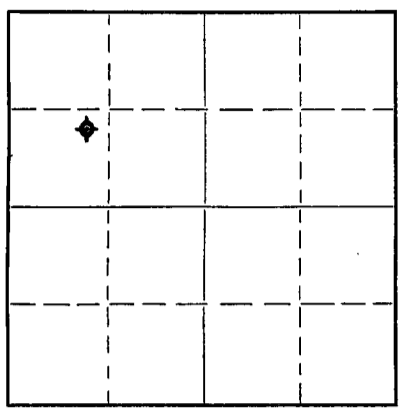

Locate well correctly on above  
Section Plat

Rooks County. Sec. 9 Twp. 10S Rge. 21W (E) (W)  
Location as "NE/CNW $\frac{1}{4}$ SW $\frac{1}{4}$ " or footage from lines NE $\frac{1}{4}$  SW $\frac{1}{4}$  NW $\frac{1}{4}$   
Lease Owner Heathman Drilling Co., Inc.  
Lease Name Veatch Well No. 3A  
Office Address 509 Orpheum Building, Wichita, Kansas  
Character of Well (completed as Oil, Gas or Dry Hole) dry hole  
Date well completed 6-18 1950  
Application for plugging filed 6-18 1950  
Application for plugging approved 6-18 1950  
Plugging commenced 6-18 1950  
Plugging completed 6-18 1950  
Reason for abandonment of well or producing formation

If a producing well is abandoned, date of last production 19  
Was permission obtained from the Conservation Division or its agents before plugging was commenced? yes

Name of Conservation Agent who supervised plugging of this well Eldon Petty  
Producing formation Depth to top Bottom Total Depth of Well Feet  
Show depth and thickness of all water, oil and gas formations.

OIL, GAS OR WATER RECORDS

CASING RECORD

Formation	Content	From	To	Size	Put In	Pulled Out
		Ran 5 jts., 137.85'		8-5/8" 28# casing		
		cemented at 139'		with 125 sacks cement		
		and 1 c.c.				

Describe in detail the manner in which the well was plugged, indicating where the mud fluid was placed and the method or methods used in introducing it into the hole. If cement or other plugs were used, state the character of same and depth placed, from feet to feet for each plug set.

Plugged with 35 sacks cement set @ 130 ft. to surface

6-27-50

(If additional description is necessary, use BACK of this sheet)

Correspondence regarding this well should be addressed to Heathman Drilling Co., Inc.  
Address 509 Orpheum Building  
Wichita, Kansas

STATE OF KANSAS, COUNTY OF SEDGWICK, ss.  
Birmingham-Bartlett Drilling Co. contractor for owner of the above-described well,  
being first duly sworn on oath, says: That I have knowledge of the facts, statements, and matters herein contained and the log of the above-described well as filed and that the same are true and correct. So help me God.

(Signature) Richard Lindery  
(Address)

SUBSCRIBED AND SWORN to before me this 23rd day of June 19 50  
Vivian J. Yinger Notary Public.

My commission expires November 29, 1950.

22-7377-s 4-49-10M

PLUGGING  
FILE SEC 9 T 10 R 20W  
BOOK PAGE 18 LINE 8

15-163-03321-0000

VEATCH #3A

LOCATION: NE 1/4 SW 1/4 NW 1/4 Sec. 9-10S-21W  
Rooks County, Kansas

OPERATOR: Heathman Drilling Co., Inc.

CONTRACTOR: Birmingham-Bartlett Drilling Co.

SURFACE CASING: Ran 5 jts., 137.85' 8-5/8" 28# casing cemented at 139' with 125 sacks cement and 1 c.c.

OIL STRING: None. D & A

Spudded: 6-9-50.  
Completed: 6-18-50  
Elevation: 2234 KB'

LOG

(Figures indicate bottom of formation)

0 to	139	Surface			
	950	Shale			
	1050	Sand and shale		Anhydrite	1722 (+512)
	1220	Shale		Heebner	3475 (-1241)
	1450	Sand		Lansing-K.C.	3517 (-1283)
	1722	Shale		Base K.C.	3740
	1761	Anhydrite		Shale Conglomerate	3777 (-1543)
	1795	Shale		Chert Conglomerate	3798
	2425	Shale and shells		Total Depth	3884 (-1650)
	2840	Line and shale			
	2935	Shale and line shells			
	3145	Shale			
	3410	Shale and line			
	3780	Line			
	3884	Conglomerate			
	3884	Total Depth			

The undersigned Richard Hindery hereby certifies that the above is a true and correct log of the formations encountered in drilling the Veatch No. 3A well as shown on the daily drilling reports.

BIRMINGHAM-BARTLETT DRILLING CO.  
BY Richard Hindery

Subscribed and sworn before me this 23rd day of June, 1950.  
Vivian Z. Unger  
Notary Public

My commission expires November 29, 1950.

JUN 27 1950  
RECORDATION  
COMMISSION  
KANSAS

**PLUGGING**  
FILE SEC 9T 10 20  
BOOK PAGE 12 LINE 8