


STATE OF KANSAS  
STATE CORPORATION COMMISSION

Give All Information Completely  
Make Required Affidavit  
Mail or Deliver Report to:  
Conservation Division  
State Corporation Commission  
800 Blitting Building  
Wichita, Kansas

WELL PLUGGING RECORD of OWDD

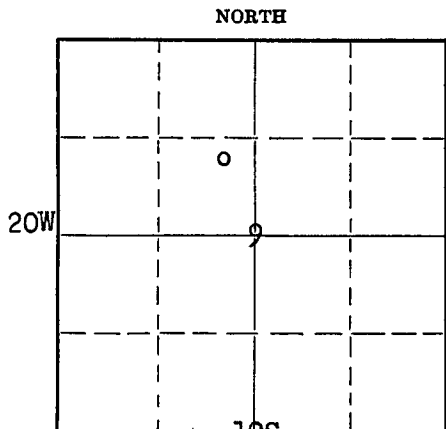

Locate well correctly on above  
Section Plat

Rooks.....County. Sec. 9 Twp. 10S Rge. (E) 20 (W)  
Location as "NE/CNW $\frac{1}{4}$ SW $\frac{1}{4}$ " or footage from lines NE $\frac{1}{4}$  SE $\frac{1}{4}$  NW $\frac{1}{4}$   
Lease Owner Heathman Drilling Co., Inc., et al  
Lease Name SELINA-VEATCH "A" Well No. 1  
Office Address 509 Orpheum Bldg., Wichita, Kansas  
Character of Well (completed as Oil, Gas or Dry Hole) dry hole  
Date well completed First spud date: 1-31-50 - Temp. Abd. 2-3-1950@ 1711  
Application for plugging filed 2nd spud date: 7-4-50 - Final Abd. 7-11-1950 ft.  
Application for plugging approved 7-11-1950  
Plugging commenced 7-11-1950  
Plugging completed 7-11-1950  
Reason for abandonment of well or producing formation ---- dry hole ----

If a producing well is abandoned, date of last production ----- 19  
Was permission obtained from the Conservation Division or its agents before plugging was com-  
menced? yes

Name of Conservation Agent who supervised plugging of this well Eldon Petty, Box 326, Hays, Kansas  
Producing formation none Depth to top ---- Bottom Final Total Depth of Well 3820 Feet  
Show depth and thickness of all water, oil and gas formations.

OIL, GAS OR WATER RECORDS

CASING RECORD

Formation	Content	From	To	Size	Put In	Pulled Out
none				8-5/8" surface cemented @ 121' w/85 sacks cement and 1 sack Cal. Chloride. none pulled out.		
				no oil string run.		

Describe in detail the manner in which the well was plugged, indicating where the mud fluid was placed and the method or methods used in  
introducing it into the hole. If cement or other plugs were used, state the character of same and depth placed, from ----- feet to  
----- feet for each plug set.

Set plug at 120 ft. then filled hole with 40 sacks cement.  
Pipe cut off 2' below level of ground.

7-17-50

(If additional description is necessary, use BACK of this sheet)

Correspondence regarding this well should be addressed to Heathman Drilling Co., Inc.  
Address 509 Orpheum Building, Wichita, Kansas


STATE OF Kansas, COUNTY OF Sedgwick ss.  
Robert F. Walters (employee of owner) of the above-described well,  
being first duly sworn on oath, says: That I have knowledge of the facts, statements, and matters herein contained and the log of the above-  
described well as filed and that the same are true and correct. So help me God.

HEATHMAN DRILLING CO., INC.  
By: Robert F. Walters  
509 Orpheum Bldg., Wichita, Kans.  
(Address)

SUBSCRIBED AND SWORN TO before me this 15th day of July, 19 50

My commission expires June 28, 1952.

Notary Public.

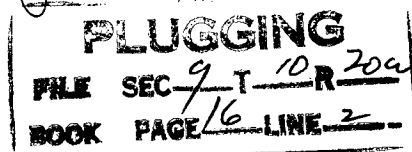

SELINA-VEATCH "A" # 1Old Well Drilled Deeper

Location:	NE/4 SE/4 NW/4 Sec.9-10S-20W Rooks County, Kansas	First Spudded:	1-31-50
Operator:	Heathman Drilling Co., Inc.	Temp. Abandoned:	2-3-50
Contractor:	Heathman Drilling Co., Inc.	Old Total Depth:	1711'
Surface Casing:	4 jts. (126.60') 8-5/8" 24# 8 rd. thd. cemented @ 121' w/85 sacks cement and 1 sack C.C.	Elevation:	2173' DF; 2170' Gr; 2175' KB
		New Total Depth:	3820'
Oil String:	none run OWDD abandoned as dry hole on 7-11-50 @ T.D. 3820'	Second Spud Date:	7-4-50
		OWDD Abandoned:	7-11-50

TOPS (KB)

Anhydrite	1669 (+ 505)
Topeka	3204 (-1029)
Hebner	3408 (-1233)
Lansing-K.C.	3447 (-1272)
Base of K.C.	3670 (-1495)
Shale Conglomerate	3698 (-1523)
Chert Conglomerate	3733 (-1558)
Total Depth (new)	3820 (-1645)

LOG

(Figures indicate bottom of formation)

Sand and shale	0 to 60
Sand and shale (surface)	137
Shale	540
Shale and shells	1150
Sand	1180
Sand	1400
Sand, red bed	1669
Anhydrite	1695
Anhydrite	1711
Shale and shells	2215
Shale - lime	2810
Shale	2920
Shale and lime	3073
Shale	3190
Lime and shale	3262
Lime	3426
Lime - shale	3479
Lime	3652
Lime and shale	3760
Chert	3820
Total Depth	3820'

**RECEIVED**

Conservation Div.

JUL 17 1950

STATION  
KANSAS

The undersigned, Heathman Drilling Co., Inc., hereby certifies that the above log is a true and correct log of the formations encountered in drilling the above named well to final total depth of 3820' where it was abandoned as a dry hole, as reflected by the daily drilling reports.

HEATHMAN DRILLING CO., INC.

BY:

Robert F. Walters  
Robert F. Walters

Subscribed and sworn to before  
me this 15th day of July 1950.

D. Marion Mott  
Notary Public

My commission expires: June 28, 1952.

**PLUGGING**

FILE SEC 9 10 R 204  
BOOK PAGE 16 LINE 2