

15-163-03078-0000


STATE OF KANSAS  
STATE CORPORATION COMMISSION

WELL PLUGGING RECORD

Give All Information Completely  
Make Required Affidavit  
Mail or Deliver Report to:  
Conservation Division  
State Corporation Commission  
800 Biting Building  
Wichita, Kansas

Rooks County, Sec. 9 Twp. 10 Rge. 20 (E) W (W)

Location as "NE/CNWxSWx" or footage from lines SW SW NW  
Lease Owner Okmar Oil Company  
Lease Name Veatch Well No. 6  
Office Address 817 Union National Bank Building, Wichita  
Character of Well (completed as Oil, Gas or Dry Hole) Dry Hole  
Date well completed 8-7 19 54  
Application for plugging filed 8-7 19 54  
Application for plugging approved 8-7 19 54  
Plugging commenced 8-7 19 54  
Plugging completed 8-7 19 54  
Reason for abandonment of well or producing formation Too low structurally

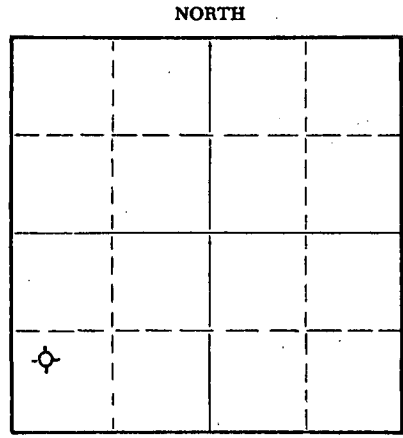

Locate well correctly on above Section Plat

If a producing well is abandoned, date of last production -- 19 --  
Was permission obtained from the Conservation Division or its agents before plugging was commenced? Yes

Name of Conservation Agent who supervised plugging of this well Eldon Petty, Hays, Kansas  
Producing formation -- Depth to top -- Bottom -- Total Depth of Well 3870 Feet  
Show depth and thickness of all water, oil and gas formations.

OIL, GAS OR WATER RECORDS

CASING RECORD

FORMATION	CONTENT	FROM	TO	SIZE	PUT IN	PULLED OUT
				8-5/8"	216.14'	

Describe in detail the manner in which the well was plugged, indicating where the mud fluid was placed and the method or methods used in introducing it into the hole. If cement or other plugs were used, state the character of same and depth placed, from -- feet to -- feet for each plug set.

Filled hole with mud to 210'; set plug; 1/2 sack hulls, 15 sacks cement, filled hole with mud to 40'; set plug then filled to top with 10 sacks cement, 1/2 sack hulls.

RECEIVED  
STATE CORPORATION COMMISSION  
8-12-54  
AUG 12 1954

CONSERVATION DIVISION  
Wichita, Kansas

(If additional description is necessary, use BACK of this sheet)  
Name of Plugging Contractor C-G Drilling Co.  
Address 107 Rule Building, Wichita, Kansas


STATE OF KANSAS, COUNTY OF SEDGWICK, ss.  
R. A. Cook (Employee or owner) or (owner or operator) of the above-described well, being first duly sworn on oath, says: That I have knowledge of the facts, statements, and matters herein contained and the log of the above-described well as filed and that the same are true and correct. So help me God.

(Signature) R. A. Cook  
R. A. COOK  
107 Rule Building, Wichita, Kansas  
(Address)

SUBSCRIBED AND SWORN TO before me this 11th day of August, 1954

Richard Donaldson  
Notary Public.

My commission expires June 17, 1957

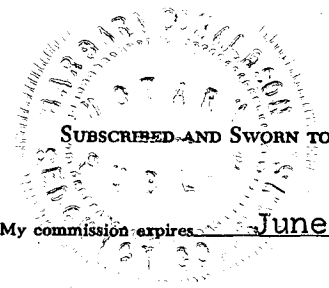

PLUGGING  
FILE SEC 9 T 10 R 20W  
BOOK 55 PAGE 11

15-163-03078-0000

CONTRACTOR'S WELL LOG

OPERATOR Okmar Oil Company FARM NAME Veatch #6  
 LOCATION SW SW NW, Section 9-10-20W  
 POOLNAME Palco S.E. COUNTY Rooks STATE Kansas  
 COMMENCEMENT DATE July 30, 1954 COMPLETION DATE August 7, 1954

LOG OF WELL

Elevation: 2255' R.B.  
 All measurements from the top of rotary bushing.

FROM	TO	FORMATION	DEVIATION FROM VERTICAL	REMARKS:
0	215	Shale		
215	600	Shale		
600	1535	Lime-Shale-Sand	0° - 1500'	
1535	1894	Shale-Lime-		
1894	2245	Shale-Shells	0° - 2000'	
2245	2475	Lime-Shale		
2475	2525	Lime-Shale	0° - 2500'	
2525	2670	Lime-Shale		
2670	2770	Lime-Shale		
2770	2885	Lime-Limey Shale		
2885	2990	Lime-Shale		
2990	3110	Lime-Shale	0° - 3000'	
3110	3215	Shale-Lime		
3215	3335	Lime-Shale		
3335	3425	Lime-Shale		
3425	3513	Lime-Shale	0° - 3500'	
3513	3585	Lime-Shale		
3585	3635	Lime-Shale		
3635	3705	Lime-Shale		
3705	3785	Lime-Shale		
3785	3830	Lime-Shale		
3830	3870	Lime-Shale		

CASING LEFT IN HOLE AFTER COMPLETION

Ran 216.14 (7 jts) 8-5/8" Surface Casing.

STATE OF KANSAS }  
 COUNTY OF SEDGWICK } ss.

The undersigned certifies that to the best of her knowledge and belief, the above facts are true and correct.

REC'D  
 STATE CORPORATION  
 AUG 11 1954  
 CONSERVATION DEPT.

C-G DRILLING CO.

By Vicky Jacobs  
Office Manager

Subscribed and sworn to before me this 10th day of August, 1954.

My commission expires: June 17, 1957

Barbara Donaldson  
Notary Public

**PLUGGING**  
 FILE SEC 9 T 10 R 20W  
 BOOK PAGE 35 LINE 18