

15-051-21781-00-00

STATE OF KANSAS
STATE CORPORATION COMMISSION

WELL PLUGGING RECORD

Give All Information Completely
Make Required Affidavit
Mail or Deliver Report to
Conservation Division
State Corporation Comm.
245 North Water
Wichita, KS 67202

Ellis County. Sec. 21 Twp. 12 Rge. 19 E/W
Location as "NE/CNW 1/4 SW 1/4" or footage from lines
C S/2 NE NE

Lease Owner Kansas Oil Corp.

Lease Name Wann - Harwood Well No. 2

Office Address 555 N. Woodlawn, Wichita, Ks.

Character of Well (Completed as Oil, Gas or Dry Hole)

Dry Hole 10-3-79 Per Sec Log

Date Well completed 5-25 KCC 1978

Application for plugging filed 6-18 af 1980

Application for plugging approved 6-20 1980

Plugging commenced 7-24 1980

Plugging completed 7-30 19

Reason for abandonment of well or producing formation


Non Commercial Value

If a producing well is abandoned, date of last production

Non Applicable 19

Was permission obtained from the Conservation Division or

its agents before plugging was commenced? yes

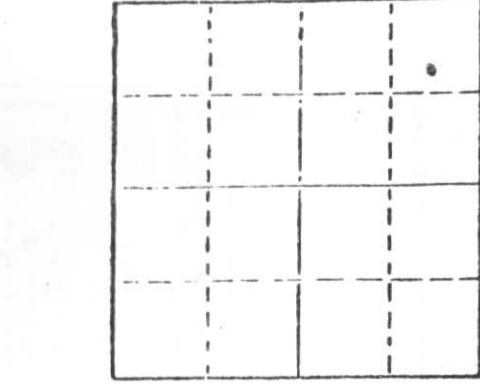

Locate well correctly on above
Section Plat

Name of Conservation Agent who supervised plugging of this well Mr. Schmidt

Producing formation None Depth to top 3234 Bottom 3240 Total Depth of Well 3750

Show depth and thickness of all water, oil and gas formations.

OIL, GAS OR WATER RECORDS

CASING RECORD

FORMATION	CONTENT	FROM	TO	SIZE	PUT IN	PULLED OUT
Surface				8 5/8	254'	0'
Production				4 1/2"	3750'	2300'

Describe in detail the manner in which the well was plugged, indicating where the mud fluid was placed and the method or methods used in introducing it into the hold. If cement or other plugs were used, state the character of same and depth placed, from _____ feet to _____ feet for each plug set.

Plugged Bottom w/ 1 sk. hulls & 10 sks. cement to 3050'
Pumped 3 sks. hulls - 6 sks. gel - 70 sks cement - 5 sks Gel
& 70 sks. cement - Pressured to 350lbs.

Allied Pumptrucks

RECEIVED
STATE CORPORATION COMMISSION
09-23-1980
SEP 23 1980

CONSERVATION DIVISION
Wichita, Kansas

(If additional description is necessary, use BACK of this sheet)
Name of Plugging Contractor Midwest Casing Pulling, Box F, Sublette, Ks. 67877 Permit # 766

STATE OF Kansas COUNTY OF Haskell, ss.
I, Edgar J. Eves (employee of owner) or (owner or operator)

of the above-described well, being first duly sworn on oath, says: That I have knowledge of the facts, statements, and matters herein contained and the log of the above-described well as filed and that the same are true and correct. So help me God.

(Signature) Edgar J. Eves
Box F, Sublette, Ks. 67877
(Address)

SUBSCRIBED AND SWORN TO before me this 17th day of August, 19 80

Sandra L Eves
Notary Public.

My commission expires 12-6-80

