

Give All Information Completely  
Make Required Affidavit  
Mail or Deliver Report to:  
Conservation Division  
State Corporation Commission  
800 Bitting Building  
Wichita, Kansas


OR  
FORMATION PLUGGING RECORD

Strike out upper line  
when reporting plugging  
off formations.

Ellis County, Sec. 22 Twp. 12S Rge. 19W (E) (W)

Location as "NE $\frac{1}{4}$ NW $\frac{1}{4}$ SW $\frac{1}{4}$ " or footage from lines C NW NW  
Lease Owner The Coralena Oil Company  
Lease Name Reeder Well No. 1  
Office Address 929 Kennedy Building, Tulsa, 3, Okla.  
Character of Well (Completed as Oil, Gas or Dry Hole) Dry Hole  
Date, well completed Aug. 18, 1943 193  
Application for plugging filed October 21, 1944 193  
Application for plugging approved October 23, 1944 193  
Plugging Commenced November 10, 1944 193  
Plugging Completed November 10, 1944 193  
Reason for abandonment of well or producing formation Dry Hole

NORTH

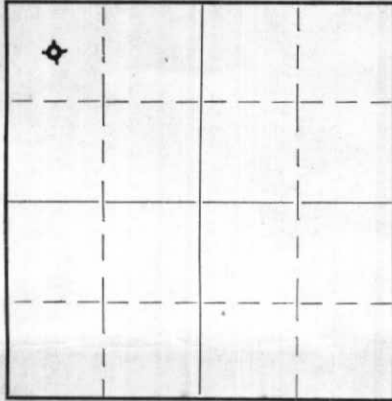

Locate well correctly on above  
Section Plat

If a producing well is abandoned, date of last production 193  
Was permission obtained from the Conservation Division or its agents before plugging was commenced? Yes

Name of Conservation Agent who supervised plugging of this well H. W. Kerr  
Producing formation Arbuckle Lime Depth to top 3864' Bottom Total Depth of Well 3887' Feet.  
Show depth and thickness of all water, oil and gas formations.


OIL, GAS OR WATER RECORDS

CASING RECORD

Formation	Content	From	To	Size	Put In	Pulled Out
Kansas City Lime	Show of oil & Water	3520'	3833'	10 3/4" 5 1/2"	125' 3579'	none 600'
Arbuckle Lime	Oil Stains & Water	3864'	3887'			

Describe in detail the manner in which the well was plugged, indicating where the mud fluid was placed and the method or methods used in introducing it into the hole. If cement or other plugs were used, state the character of same and depth placed, from feet to feet for each plug set.

- 3887 T.D.
- 3555 Plugged Back
- 3555 - 125 Heavy Mud
- 125 - 100 Cement - 10 sacks
- 100 - 10 Mud & Bridge
- 10 - 0 Cement - 5 sacks

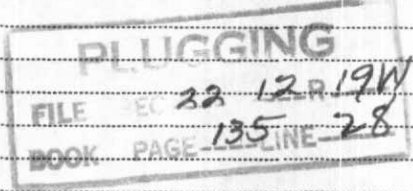

(If additional description is necessary, use BACK of this sheet)

Correspondence regarding this well should be addressed to The Coralena Oil Company  
Address 929 Kennedy Building, Tulsa, 3, Oklahoma

STATE OF Oklahoma, COUNTY OF Tulsa, ss.  
Frank Bennett (employee of owner) or (owner or operator) of the above-described well,

being first duly sworn on oath, says: That I have knowledge of the facts, statements, and matters herein contained and the log of the above-described well as filed and that the same are true and correct. So help me God.

(Signature) *Frank Bennett*

929 Kennedy Building, Tulsa, 3, Oklahoma  
(Address)

SUBSCRIBED AND SWORN to before me this 14th day of November

My commission expires MISSION EXPIRES DEC. 13, 1947




15-051-04477-00-00

THE CORALENA OIL COMPANY  
929 Kennedy Building  
Tulsa, 3, Oklahoma

WELL LOG: Reeder #1, C NW NW, Sec. 22-12S-19W, Ellis County, Kansas

<u>FROM</u>	<u>TO</u>	<u>REMARKS</u>
0	35	Clay
35	136	Shale and shells
136	236	Sand and shale
236	525	Shale and shells
525	555	Sand
555	679	Shale and shells
679	736	Sand and shale
736	1020	Red rock, sand and shale
1020	1270	Shale & shells
1270	1507	Red rock, shale and shells
1507	1558	Anhydrite
1558	1845	Shale and shells
1845	1940	Red rock and shale
1940	2080	Salt
2080	2146	Shale
2146	2209	Lime and shale
2209	2340	Shale
2340	2369	Lime and shale
2369	2399	Lime
2399	2440	Shale and shells
2440	2455	Sand and shale
2455	2507	Shale
2507	2513	Lime
2513	2560	Lime & shale
2560	2650	Shale
2650	2835	Lime and shale
2835	2872	Shale - streaks of lime.
2872	2928	Lime & shale. SLM @ 2884 OK
2928	3007	Shale and shells
3007	3048	Lime & shale
3048	3100	Shale
3100	3247	Shale and shells Topeka @ 3247
3247	3259	Shale and shells
3259	3267	Lime
3267	3335	Lime & shale
3335	3361	Lime
3361	3398	Lime and shale SLM 3365=3367
3398	3429	Lime
3429	3449	Lime and shale
3449	3458	Red rock and shale Dodge @ 3458
3458	3478	Lime - white
3478	3520	Variegated shale and streaks of lime. Pyrite K. C. @ 3520
3520	3523	Lime
3523	3534	Lime - spotted saturation - dead oil. Poor porosity
3534	3539	Lime
3539	3570	Lime and shale
3570	3574	Lime - spotted saturation
3574	3583	Lime - gray, hard
3583	3590	Lime - saturation
3590	3649	Lime and shale
3649	3651	Lime - spotted saturation - water
3651	3700	Lime - hard, Streaks of shale
3700	3707	Lime - spotted sat. - water
3707	3798	Lime
3798	3828	Lime, red rock and shale

**PLUGGING**  
 22 12R-19W  
 PAGE 135 LINE 28

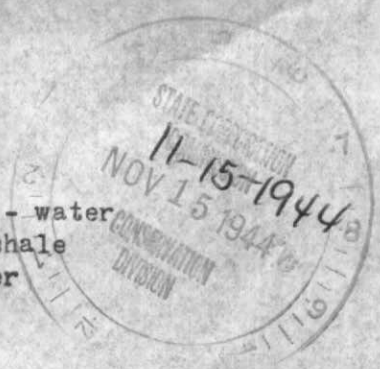

15-051-04477-00-00

CORALENA OIL CO., Well Log (Reeder #1) Cont'd

-2-

<u>FROM</u>	<u>TO</u>	<u>REMARKS</u>
3828	3833	Lime
3833	3864	Conglomerate and variegated shale
3864	3887	Dolomite - cherty. Stain & porosity
	3887	Total Depth
	3555	P. B.

Perforated 3522-3536 with 34 shots.  
Acidized with 2,000 gal. Made 10 Bbls. water and no oil.

Dry and abandoned.

Commenced: 8-1-43  
Completed: 8-18-43

I. P. - D. & A.

Casing Record

10 3/4" @ 125' 70 sacks  
5" @ 3579' 100 "

