


STATE OF KANSAS
STATE CORPORATION COMMISSION

Give All Information Completely
Make Required Affidavit
Mail or Deliver Report to:
Conservation Division
State Corporation Commission
800 Bitting Building
Wichita, Kansas

15-051-00498-00-00

WELL PLUGGING RECORD

NORTH

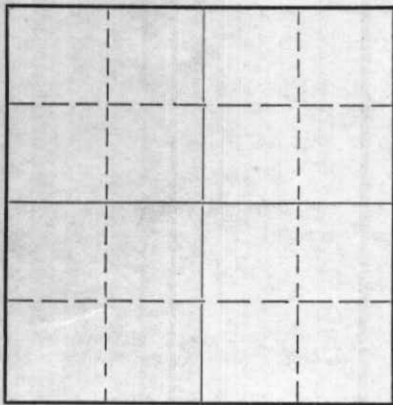

Locate well correctly on above Section Plat

Ellis County. Sec. 26 Twp 12S Rge. 19W ~~W~~ W (W)
Location as "NE/CNW $\frac{1}{4}$ SW $\frac{1}{4}$ " or footage from lines NW NE SE
Lease Owner R. W. Rine Drilling Co., et al
Lease Name Ubert Well No. 1
Office Address 320 Central Bldg., Wichita 2, Kansas
Character of Well (completed as Oil, Gas or Dry Hole) Dry Hole
Date well completed December 23, 1950
Application for plugging filed December 23, 1950
Application for plugging approved December 23, 1950
Plugging commenced December 23, 1950
Plugging completed @ 3:00 P.M. December 23, 1950
Reason for abandonment of well or producing formation Dry Hole
If a producing well is abandoned, date of last production 19
Was permission obtained from the Conservation Division or its agents before plugging was commenced? Yes. Via telephone.

Name of Conservation Agent who supervised plugging of this well Eldon Petty, Dist. Plugging Supervisor
Producing formation None Depth to top Bottom Total Depth of Well 39.35 Feet
Show depth and thickness of all water, oil and gas formations.

OIL, GAS OR WATER RECORDS

CASING RECORD

Formation	Content	From	To	Size	Put In	Pulled Out
Surface	Sand	0'	45'			
Shale & Shells	same	45'	221'	8-5/8"	218'	None

Describe in detail the manner in which the well was plugged, indicating where the mud fluid was placed and the method or methods used in introducing it into the hole. If cement or other plugs were used, state the character of same and depth placed, from feet to feet for each plug set.

Heavy mud from Total depth to 210'
Halliburton plug @ 210' w/ 25 Sx. Cement
Heavy mud from plug @ 210' to 40'
Halliburton plug @ 40' w/ 10 Sx. Cement

RECEIVED
STATE CORPORATION COMMISSION
DEC 30 1950
Wichita, Kansas
CONSERVATION DIVISION
12 30 1950

(If additional description is necessary, use BACK of this sheet)

Correspondence regarding this well should be addressed to The R. W. Rine Drilling Company
Address 320 Central Bldg., Wichita 2, Kansas

STATE OF Kansas, COUNTY OF Sedgwick, ss.
E. H. Sloyer (employee of owner) or (owner or operator) of the above-described well,
being first duly sworn on oath, says: That I have knowledge of the facts, statements, and matters herein contained and the log of the above-described well as filed and that the same are true and correct. So help me God.

(Signature) E. H. Sloyer Secretary
320 Central Bldg., Wichita 2, Kansas (Address)

SUBSCRIBED AND SWORN to before me this 27th day of December, 1950.

Vina A. McKenney Notary Public.

My commission expires September 18, 1952

22-7377-s 4-49-10M

PLUGGING
FILE SEC 26 12 R 1950
BOOK PAGE 51 LINE 19

15-051-00498-00-00

Ubert Well No. 1

NW NE SE
Sec. 26-12S-19W
Ellis County, Kansas

Contractor: The R. W. Rine Drilling Company
Started 12/13/50 Finished 12/23/50

LOG

Surface Clay	0	-	35	
Sand	35	-	45	
Shale & Shells	45	-	221	
Shale	221	-	710	Syfo 500' - 0°
Sand	710	-	815	
Shale, Shells	815	-	1035	Syfo 1000' - 0°
Sand	1035	-	1150	
Shale	1150	-	1520	Syfo @ 1500' - 0.K.
Anhydrite	1520	-	1560	
Shale, Shells	1560	-	2160	Syfo @ 2000' - 1/2°
Lime	2160	-	2495	
Shale, Lime	2495	-	3130	Syfo @ 3000' - 0.K.
Lime	3130	-	3335	
Lime, Shale	3335	-	3415	
Lime	3415	-	3935	T.D.

Tops: Sample

Topeka	3226
Kansas City	3464
Base Kansas City	3716
Conglomerate	3840
Arbuckle	3905

Schlumberger

Heebner	3494
Dodge	3516
Kansas City	3544
Arbuckle	3900
T.D.	3935

State of Kansas)
County of Sedgwick) ss.

I, E. H. Sloyer, do hereby certify that the above is a true and accurate log of the Ubert Well No. 1, located in the NW NE SE of Section 26-12S-19W, Ellis County, Kansas.

E. H. Sloyer
Secretary

Subscribed to and sworn before me this 27th day of December, 1950

Viva A. McKenzie
Notary Public

My Commission Expires September 18, 1952

PLUGGING
FILE SEC 26-12S-19W
BOOK PAGE 51 LINE 19

RECEIVED
STATE CORPORATION COMMISSION
DEC 30 1950
CONSERVATION DIVISION
Wichita, Kansas
12-30-1950