

15-051-19256-00-00


Give All Information Completely
Make Required Affidavit
Mail or Deliver Report to:
Conservation Division
State Corporation Commission
211 No. Broadway
Wichita, Kansas

WELL PLUGGING RECORD

Ellis County, Sec. 10 Twp. 12 Rge. 20 (E) W (W)

Location as "NE/CNW*SW*" or footage from lines NW NE SE
Lease Owner ~~XXXX~~ Don E. Pratt, Oil Operations
Lease Name Armbrister Well No. 1
Office Address Hays, Kansas
Character of Well (completed as Oil, Gas or Dry Hole) _____
Date well completed _____ 19____
Application for plugging filed _____ 19____
Application for plugging approved _____ 19____
Plugging commenced 8-9-63 _____ 19____
Plugging completed 8-14-63 _____ 19____
Reason for abandonment of well or producing formation Depleted.

NORTH

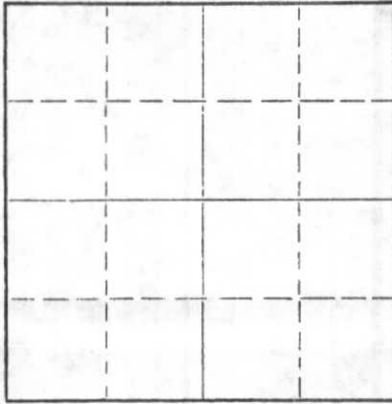

Locate well correctly on above Section Plat

If a producing well is abandoned, date of last production _____ 19____
Was permission obtained from the Conservation Division or its agents before plugging was commenced? yes

Name of Conservation Agent who supervised plugging of this well Eldon Petty
Producing formation _____ Depth to top _____ Bottom _____ Total Depth of Well 4010 Feet
Show depth and thickness of all water, oil and gas formations.

OIL, GAS OR WATER RECORDS

CASING RECORD

FORMATION	CONTENT	FROM	TO	SIZE	PUT IN	PULLED OUT
				8-5/8"	170'	None
				XXXX		
				4-1/2"	4009'	3221'

Describe in detail the manner in which the well was plugged, indicating where the mud fluid was placed and the method or methods used in introducing it into the hole. If cement or other plugs were used, state the character of same and depth placed, from _____ feet to _____ feet for each plug set.

Checked hole, sanded hole to 3600' and dumped 5 sacks of cement @ 3600' with dump bailer. Pulled 4 1/2" casing to 550' and pumped in mud to 550' and pumped 20 sacks of cement. Pulled 4 1/2" casing to 200' and pumped 20 sacks of cement. Pulled balance of pipe and ran 10 sacks of cement from 30' to base of cellar.

PLUGGING COMPLETE.

RECEIVED
STATE CORPORATION COMMISSION
SEP 9 1963
09-09-1963
CONSERVATION DIVISION
Wichita, Kansas

(If additional description is necessary, use BACK of this sheet)

Name of Plugging Contractor KNIGHT CASING PULLING COMPANY
Address CHASE, KANSAS

STATE OF KANSAS, COUNTY OF RICE, ss.
Noel J. Knight (employee of owner) or (owner/operator) of the above-described well, being first duly sworn on oath, says: That I have knowledge of the facts, statements, and matters herein contained and the log of the above-described well as filed and that the same are true and correct. So help me God.

(Signature) Noel J. Knight
Chase, Kansas
(Address)

SUBSCRIBED AND SWORN TO before me this 19th day of August, 1963

My commission expires May 20, 1964

Milton J. Volin
Notary Public.

15-051-19256-00-00

DRILLERS LOG

Armbrister No. 1

CASING RECORD:	COMPANY: Don Pratt	DESCRIPTION: NW NE SE
8 5/8" @ 170'	CONTRACTOR: Red Tiger Drilling Co.	10-128-20
w/140 sx cement	COMMENCED: December 27, 1962	Ellis Co.,
4 1/2" @ 4009'	COMPLETED: January 8, 1963	Kansas
w/150 sx cement	ELEVATION: 2272 DF	
TOTAL DEPTH: 4010'		2275 RB

<u>FORMATION</u>	<u>FROM</u>	<u>TO</u>	<u>REMARKS</u>
Clay Rock & Sand Shale	0	171	
Chalky shale & Clay	171	230	
Blue shale	230	672	
Sand	672	700	
Grey shale	700	855	
Shale & Shells	855	1372	
Red Bed & Shale	1372	1660	
Shale & Shells	1660	2130	
Shale & Lime	2130	3352	
Lime	3352	3815	
Lime & Shale	3815	3905	
Lime Shale & Chert	3905	3961	
Arbuckle	3961	4010	

RECEIVED
 STATE CORPORATION COMMISSION
 SEP 9 1963
 09-09-1963
 CONSERVATION DIVISION
 Wichita, Kansas

I certify that this is a true and correct copy of the above log to the best of my knowledge.

RED TIGER DRILLING COMPANY

George A. Angle
 George A. Angle

Subscribed and sworn to before me this 8th day of January, 1963.

Jean Holler
 Notary Public

