


WELL PLUGGING RECORD

Give All Information Completely
Make Required Affidavit
Mail or Deliver Report to:
Conservation Division
State Corporation Commission
311 No. Broadway
Wichita, Kansas

NORTH

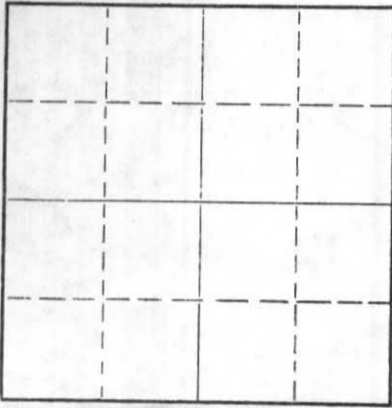

Locate well correctly on above
Section Plat

Ellis County. Sec. 10 Twp. 12 Rge. 20 W(E) (W)
Location as "NE/CNW/SW" or footage from lines SE SW SE
Lease Owner Don Pratt
Lease Name Westhusin Well No. 1
Office Address Box 656, Hays, Kansas
Character of Well (completed as Oil, Gas or Dry Hole) D & A
Date well completed July 4, 1963
Application for plugging filed July 4 1963
Application for plugging approved July 4 1963
Plugging commenced July 4 1963
Plugging completed July 4 1963
Reason for abandonment of well or producing formation D & A

If a producing well is abandoned, date of last production _____ 19____
Was permission obtained from the Conservation Division or its agents before plugging was commenced? Yes

Name of Conservation Agent who supervised plugging of this well Eldon Petty
Producing formation _____ Depth to top _____ Bottom _____ Total Depth of Well 3998 Feet
Show depth and thickness of all water, oil and gas formations.

OIL, GAS OR WATER RECORDS

CASING RECORD

FORMATION	CONTENT	FROM	TO	SIZE	PUT IN	PULLED OUT
				8 5/8"	191'	-0-

Describe in detail the manner in which the well was plugged, indicating where the mud fluid was placed and the method or methods used in introducing it into the hole. If cement or other plugs were used, state the character of same and depth placed, from _____ feet to _____ feet for each plug set.

Plugged hole with heavy mud,
set plug 600', 20 sx cement.
Plug @ 180', 15 sx cement, 40'
10 sx cement.

RECEIVED
STATE CORPORATION COMMISSION

JUL 11 1963
07-11-1963
CONSERVATION DIVISION
Wichita, Kansas

(If additional description is necessary, use BACK of this sheet)
Name of Plugging Contractor Red Tiger Drilling Company
Address Box 173--Russell, Kansas

STATE OF KANSAS, COUNTY OF SEDGWICK, ss.
George A. Angle (employee of owner or operator) of the above-described well, being first duly sworn on oath, says: That I have knowledge of the facts, statements, and matters herein contained and the log of the above-described well as filed and that the same are true and correct. So help me God.

(Signature) George A. Angle
1720 Wichita Plaza, Wichita 2, Kansas
(Address)

SUBSCRIBED AND SWORN to before me this 8th day of July, 1963

Jean Dollar
Notary Public.

My commission expires 5-22-66

15-051-04110-00-00-00

DRILLERS LOG

#1 Westhusin

CASING RECORD: 8 5/8" @ 191' w/140 sx cement
 COMPANY: Don Pratt
 CONTRACTOR: Red Tiger Drilling Co.
 COMMENCED: June 28, 1963
 COMPLETED: July 4, 1963
 DESCRIPTION: SE SW SE 10-128-20W Ellis Co., Kansas
 ELEVATION:

TOTAL DEPTH: 3998'

<u>FORMATION</u>	<u>FROM</u>	<u>TO</u>	<u>REMARKS</u>
Surface	0	191	
Shale	191	1000	
Sand & Shale	1000	1145	
Sand	1145	1340	
Shale & Redbed	1340	1670	
Anhydrite	1670	1707	
Shale	1707	2030	
Shale & Shells	2030	2300	
Shale & Lime	2300	3348	
Lime	3348	3998	

I certify that this is a true and correct copy of the above log to the best of my knowledge.

RED TIGER DRILLING COMPANY

George A. Angle
George A. Angle

Subscribed and sworn to before me this 8th day of July, 1963.

RECEIVED
STATE CORPORATION COMMISSION

JUL 11 1963
07-11-1963

CONSERVATION DIVISION
Wichita, Kansas

Frank Hollas
Notary Public

My Commission Expires:

8-22-63

