


WELL PLUGGING RECORD

Give All Information Completely
Make Required Affidavit
Mail or Deliver Report to:
Conservation Division
State Corporation Commission
212 No. Market
Wichita, Kansas

NORTH

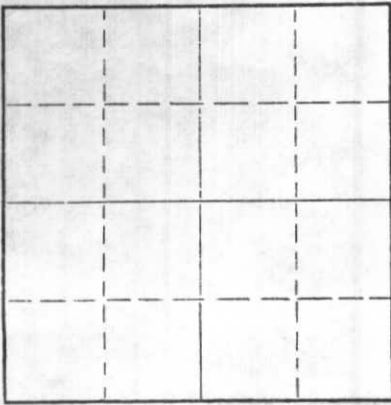

Locate well correctly on above
Section Plat

Ellis County. Sec. 10 Twp. 12 Rge. 20 (E) W (W)
Location as "NE/CNW/SW" or footage from lines. SE-NW-NW
Lease Owner L. J. Dreiling & Sons, Inc.
Lease Name Hall Well No. 1
Office Address Route 2, Victoria, Kansas 67671
Character of Well (completed as Oil, Gas or Dry Hole) Dry Hole
Date well completed 10-6 19 67
Application for plugging filed 10-6 19 67
Application for plugging approved 10-6 19 67
Plugging commenced 10-6 19 67
Plugging completed 10-6 19 67
Reason for abandonment of well or producing formation Dry Hole

If a producing well is abandoned, date of last production _____ 19____
Was permission obtained from the Conservation Division or its agents before plugging was commenced? _____

Name of Conservation Agent who supervised plugging of this well Leo Massey
Producing formation _____ Depth to top _____ Bottom _____ Total Depth of Well _____ Feet
Show depth and thickness of all water, oil and gas formations.

OIL, GAS OR WATER RECORDS

CASING RECORD

FORMATION	CONTENT	FROM	TO	SIZE	PUT IN	PULLED OUT
SURFACE PIPE				8 5/8"	140'	

Describe in detail the manner in which the well was plugged, indicating where the mud fluid was placed and the method or methods used in introducing it into the hole. If cement or other plugs were used, state the character of same and depth placed, from _____ feet to _____ feet for each plug set.

1st. plug was set at 800' with 100 sacks cement
2nd. plug was set at 150' with 25 sacks
3rd plug was set with solid bridge at 40' with 10 sacks cement
and filling hole to bottom of cellar.

RECEIVED
STATE CORPORATION COMMISSION
OCT 10 1967
10-10-1967
CONSERVATION DIVISION
Wichita, Kansas

(If additional description is necessary, use BACK of this sheet)

Name of Plugging Contractor L. J. Dreiling & Sons, Inc.
Address Route 2, Victoria, Kansas 67671

STATE OF KANSAS, COUNTY OF ELLIS, ss.
I, Leo F. Dreiling (employee of owner) or (owner or operator) of the above-described well, being first duly sworn on oath, says: That I have knowledge of the facts, statements, and matters herein contained and the log of the above-described well as filed and that the same are true and correct. So help me God.

(Signature) Leo F. Dreiling
LEO F. DREILING ROUTE 2, VICTORIA, KANSAS
(Address)

Subscribed and sworn to before me this 9th day of October, 19 67



My commission expires September 19, 1970
Joseph A. Hess Notary Public.

15-051-20132-00-00

L. J. DREILING and SONS, Inc.

VICTORIA, KANSAS

WELL LOG

Company	L. J. Dreiling & Sons, Inc. Route 2 Victoria, Kansas 67671	Sec. 10	Twp. 12	Rng. 20
Farm	Hall No. 1	Location	SE-NW-NW	
Total Depth	3605'	County	Ellis	
Comm.	10-2-67	Comp.	10-6-67	
Contractor	L. J. Dreiling & Sons, Inc. Route 2, Victoria, Kansas 67671	Elevation:	2248'	K.B.
	Casing Record		2245'	D. F.
			2243'	G. R.
		Cement Record	Production: D & A	
	140' - 8 5/8"	125 sacks cement		

Figures Indicate Bottom of Formations

0'	60'	Top Soil & Gravel
60'	90'	Yellow Clay
90'	140'	Shale
140'	565'	Shale
565'	755'	Sand
755'	1250'	Shale & Redbed
1250'	1652'	Redbed & Shale
1652'	1701'	Anhy.
1701'	1890'	Shale & Shells
1890'	2190'	Shale & Shells
2190'	2335'	Shale with Lime
2335'	2570'	Shale & Lime
2570'	2770'	Shale & Lime
2770'	2962'	Shale & Lime
2962'	3200'	Shale & Lime
3200'	3350'	Shale & Lime
3350'	3505'	Shale & Lime
3505'	3585'	Lime Broken
3585'	3602'	Lime
3602'	3605'	Lime
3605'	T.D.	

RECEIVED
 WHITE CORPORATION COMMISSIONER
 OCT 10 1967
 10-10-1967
 CONSERVATION DIVISION
 Wichita, Kansas

STATE OF KANSAS)
)ss
 COUNTY OF ELLIS)

I, Leo F. Dreiling, of the L. J. Dreiling & Sons, Inc., upon oath states that the above and foregoing is a true and correct copy from the Daily Drilling Report from our Hall #1.

Leo F. Dreiling
 LEO F. DREILING

Subscribed and sworn to before me this 9th day of October 1967.

Joseph A. Hess
 JOSEPH A. HESS NOTARY PUBLIC



My commission expires: September 19, 1970