


STATE OF KANSAS  
STATE CORPORATION COMMISSION  
Give All Information Completely  
Make Required Affidavit  
Mail or Deliver Report to:  
Conservation Division  
State Corporation Commission  
800 Bitting Building  
Wichita, Kansas

OR  
FORMATION PLUGGING RECORD

Strike out upper line  
when reporting plug-  
ging off formations.

Ellis County. Sec 22 Twp. 12 Rge. 19 (X) (W)  
Location as "NE 1/4 NW 1/4 SW 1/4" or footage from lines SE SE NE  
Lease Owner Alladdin Petroleum Corporation  
Lease Name Reeder Well No. 1  
Office Address 809 Petroleum Building, Wichita 2, Kansas  
Character of Well (completed as Oil, Gas or Dry Hole) Dry Hole  
Date well completed September 20 1948  
Application for plugging filed September 20 1948  
Application for plugging approved September 20 1948  
Plugging commenced September 21 1948  
Plugging completed September 21 1948  
Reason for abandonment of well or producing formation Dry Hole

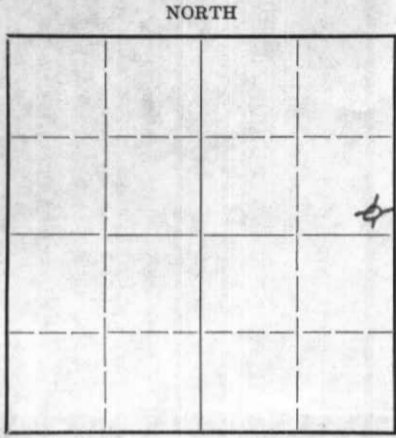

Locate well correctly on above  
Section Plat

If a producing well is abandoned, date of last production 19  
Was permission obtained from the Conservation Division or its agents before plugging was com-  
menced? Yes

Name of Conservation Agent who supervised plugging of this well M. A. Rives  
Producing formation Depth to top Bottom Total Depth of Well 4000 Feet  
Show depth and thickness of all water, oil and gas formations.


OIL, GAS OR WATER RECORDS

CASING RECORD

Formation	Content	From	To	Size	Put In	Pulled Out
				8-5/8"	270'	None

Describe in detail the manner in which the well was plugged, indicating where the mud fluid was placed and the method or methods used in introducing it into the hold. If cement or other plugs were used, state the character of same and depth placed, from feet to feet for each plug set.

Circulate heavy mud in hole - pushed #1 plug to 250' - cemented with 15 sacks cement - fill hole to 30' of top - pushed #2 plug to 30' - cemented with 10 sacks cement - plugged by Halliburton.

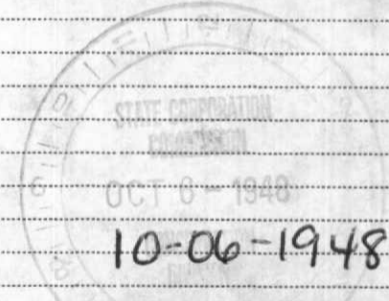

(If additional description is necessary, use BACK of this sheet)  
Correspondence regarding this well should be addressed to Virginia Drilling Company, Inc.  
Address 701 Brown Building, Wichita 2, Kansas

STATE OF Kansas, COUNTY OF Sedgwick, ss.  
S. A. Murphy (employee of owner) or (owner or operator) of the above-described well,  
being first duly sworn on oath, says: That I have knowledge of the facts, statements, and matters herein contained and the log of the above-described well as filed and that the same are true and correct. So help me God.

(Signature) S. A. Murphy  
701 Brown Building, Wichita 2, Kansas  
(Address)

SUBSCRIBED AND SWORN TO before me this 29th day of September 1948  
My commission expires 2/5/49  
Notary Public.



PLUGGING  
FILE SEC 77-T-17R-19W  
BOOK PAGE 58 LINE 18

Well: Reeder #1  
 Location: SE SE NE Section 22-12S-19W, Ellis County, Kansas  
 Company: Adding Petroleum Corporation  
 Contractor: Virginia Drilling Company, Inc.  
 Commenced: September 3, 1948  
 Completed: September 20, 1948  
 Total Depth: 4000  
 Elevation:

FORMATION	DEPTH	CIRCULATE:	
Clay-shale	0-85		
Shale-shells	185-270	© 3643 - 1 1/2 hr	
Shale-shells	270-465	3741 1 1/2 hr	
Shale (sticky)	465-530	3782 1 1/2 hr	
Shale -shells	530-590	3924 1 hr	
Sand	590-855	3967 1 hr	
Shale-shells	855-950		
Sand	950-1165		
Sand	1165-1225		
Shale	1225-1240	TOPS:	
Red bed - sandy-shale	1240-1525	Topeka	3264
Sandy shale	1525-1535	Lansing-KC	3528
Anhydrite	1535-1585	Weathered Simpson	3918
Shale-shells	1585-2215	Weathered Arbuckle	3941
Lime	2215-2260	Arbuckle	3956
Shale	2260-2340		
Lime-shale	2340-2615		
Lime	2615-2665		
Shale-shells	2665-2700		
Shale-red	2700-2725		
Lime	2725-2740		
Lime, broken	2740-2805		
Lime-shale	2805-2885		
Lime	2885-2910		
Shells-shale	2910-2930		
Shale-lime	2930-2995		
Shale	2995-3020		
Shale-lime	3020-3165		
Lime	3165-3190		
Shale-shells	3190-3255		
Shale-lime	3255-3345		
Lime	3345-3357		
Shale	3357-3377		
Lime	3377-3385		
Lime-shale	3385-3400		
Lime	3400-3475		
Lime-hard	3475-3515		
Lime-little chert	3515-3540		
Lime	3540-3560		
Lime-Kansas City	3560-3590		
Lime	3590-3875		
Shale-lime	3875-3924		
Lime	3924-3954		
Sand-lime	3954-3960		
Arbuckle chert	3960-4000		



Now comes S. A. Murphy, who states that he is familiar with the drilling of oil and gas wells and knows of his own knowledge that the Reeder #1, located in the SE SE NE of Section 22-12S-19W, Ellis County, Kansas, was drilled to a total depth of 4000 feet. Same was plugged and abandoned.

*S. A. Murphy*

Subscribed and sworn to before me, a Notary Public, this 29<sup>th</sup> day of September, 1948.

*Musie Hawkin*

My commission expires February 5, 1949.

**PLUGGING**  
 FILE SEC 22-12S-19W  
 BOOK PAGE 28 LINE 18