


15-051-00179-0000

WELL PLUGGING RECORD

Give All Information Completely
Make Required Affidavit
Mail or Deliver Report to:
Conservation Division
State Corporation Commission
800 Bitting Building
Wichita, Kansas

NORTH

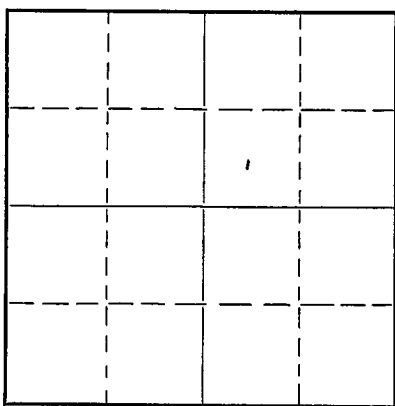

Locate well correctly on above
Section Plat

Ellis County, Sec. 28 Twp. 12S Rge. 18 (X) (W)
Location as "NE/CNW 1/4 SW 1/4" or footage from lines SW SW NE
Lease Owner Welch & Olsson Drilling Co., Inc.
Lease Name Joy Well No. 1
Office Address 1017 Union Nat'l Bank Bldg., Wichita, Kans.
Character of Well (completed as Oil, Gas or Dry Hole) Dry Hole
Date well completed 6-6 19.53
Application for plugging filed 6-6 19.53
Application for plugging approved 6-6 19.53
Plugging commenced 6-6 19.53
Plugging completed 6-6 19.53
Reason for abandonment of well or producing formation Dry Hole

If a producing well is abandoned, date of last production 19.
Was permission obtained from the Conservation Division or its agents before plugging was commenced? Yes

Name of Conservation Agent who supervised plugging of this well Eldon Petty
Producing formation Depth to top Bottom Total Depth of Well 3850 Feet
Show depth and thickness of all water, oil and gas formations.

OIL, GAS OR WATER RECORDS

CASING RECORD

Formation	Content	From	To	Size	Put In	Pulled Out
	Surface casing			8-5/8"	225'	

Describe in detail the manner in which the well was plugged, indicating where the mud fluid was placed and the method or methods used in introducing it into the hole. If cement or other plugs were used, state the character of same and depth placed, from feet to feet for each plug set.

Heavy mud to the bottom of the surface hole. First plug set at 215'. Cemented with 15 sacks. Filled hole with heavy mud to within 40' of the top, 1/2 sack of Halls. Second plug at 40'. Cemented to the bottom of the cellar.

RECEIVED
STATE CORPORATION COMMISSION
JUL 23 1953
07-20-1953
CONSERVATION DIVISION
Wichita, Kansas

(If additional description is necessary, use BACK of this sheet)
Correspondence regarding this well should be addressed to Welch & Olsson Drilling Co., Inc.
Address 1017 Union Nat'l Bank Bldg., Wichita, Ks.

STATE OF Kansas, COUNTY OF Sedgwick, ss.
R. E. Welch (Employee of owner or (owner or operator) of the above-described well,
being first duly sworn on oath, says: That I have knowledge of the facts, statements, and matters herein contained and the log of the above-described well as filed and that the same are true and correct. So help me God.

(Signature) *R. E. Welch*
1017 Union Nat'l Bank Bldg., Wichita, Ks (Address)

SUBSCRIBED AND SWORN to before me this 11th day of June, 1953.
Marcella H. Davis
Notary Public.

My commission expires Feb 27-1956

23-3273-s 4-50
PLUGGING
FILE SEC 28 T 12 R 180
BOOK PAGE 107 LINE 28

15-051-00179-00-00

WELL LOG

WELCH & OLSSON DRILLING CO., INC.

Elevation: 2155 K.B.

Contractor: Welch & Olsson Drlg Co., Inc.

Commenced Drlg: 5-25-53

Completed Drlg: 6-6-53

Joy #1
SW SW NE
Sec. 28-12-18
Ellis County, Kansas

Production: D & A

Casing Record:
225' of 8-5/8". Cemented with 150 sacks of cement.

(Figures indicate bottom of formations)

<u>FORMATIONS</u>	<u>DEPTHS</u>	<u>FORMATION TOPS</u>
Surface	85	Anhydrite 1440
Shale & Clay stks	224	Heebner 3404
Shale	660	Lansing 3451
Sand & shale stks	680	Base of KC 3690
Sand	700	Conglomerate 3732
Shale	845	Arbuckle 3806
Sand	1090	
Shale & shells	1440	
Anhydrite	1470	
Shale & shells	2300	
Shale & Lime	2350	
Shale & shells	2495	
Lime & shale	2680	
Shale & shells	3190	
Lime & shale	3260	
Lime	3400	
Lime with shale stks	3440	
Lime	3760	
Conglomerate-cherty	3787	
Cherty-conglomerate	3825	
Arbuckle	3850 T.D.	

STATE OF KANSAS
JUL 20 1953
RESERVATION DIVISION
Wichita, Kansas

28 12 180
107 28

STATE OF KANSAS,
(SS:-
SEDGWICK COUNTY,)

I hereby certify that the above is a true and correct copy of the Drillers Log of the well drilled in the SW SW NE of Section 28, Township 12, Range 18, Ellis County, Kansas.

WELCH & OLSSON DRILLING CO., INC.

By: [Signature]

Subscribed and sworn to before me this 9th day of June, 1953.

Marcella A. Davis
Notary Public.

My commission expires Feb 27-1956.

