


Give All Information Completely  
Make Required Affidavit  
Mail or Deliver Report to:  
Conservation Division  
State Corporation Commission  
211 No. Broadway  
Wichita, Kansas

15-051-00346-00-00

WELL PLUGGING RECORD

NORTH

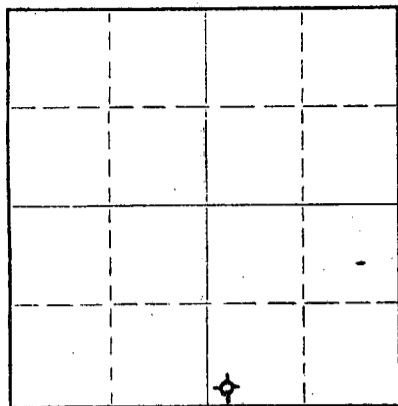

Locate well correctly on above Section Plat

Ellis

County. Sec. <sup>28</sup> 33 Twp. 12s Rge. 18 (E) (W) X

Location as "NE/CNW/SW" or footage from lines SW SW SE  
Lease Owner Jay Bergman Oil Company  
Lease Name Dumler Well No. #1  
Office Address 425 Union Center Building -- Wichita, Kansas  
Character of Well (completed as Oil, Gas or Dry Hole) Dry Hole  
Date well completed December 23, 1958  
Application for plugging filed December 23, 1958  
Application for plugging approved December 24, 1958  
Plugging commenced December 24, 1958  
Plugging completed December 24, 1958  
Reason for abandonment of well or producing formation Dry Hole

If a producing well is abandoned, date of last production 19  
Was permission obtained from the Conservation Division or its agents before plugging was commenced? Yes

Name of Conservation Agent who supervised plugging of this well Eldon Petty  
Producing formation \_\_\_\_\_ Depth to top \_\_\_\_\_ Bottom \_\_\_\_\_ Total Depth of Well 3804 Feet  
Show depth and thickness of all water, oil and gas formations.

OIL, GAS OR WATER RECORDS

CASING RECORD

FORMATION	CONTENT	FROM	TO	SIZE	PUT IN	PULLED OUT

Describe in detail the manner in which the well was plugged, indicating where the mud fluid was placed and the method or methods used in introducing it into the hole. If cement or other plugs were used, state the character of same and depth placed, from \_\_\_\_\_ feet to \_\_\_\_\_ feet for each plug set.

Circulate hole with mud. Set plug at 550 feet with 20 sacks of cement through drill pipe.  
Set plug at 180 feet with 15 sacks of cement. Set plug at 40 feet with 1/2 sack hulls and 10 sacks of cement.

RECEIVED  
STATE CORPORATION COMMISSION  
DEC 29 1958  
12-29-1958  
CONSERVATION DIVISION  
Wichita, Kansas

(If additional description is necessary, use BACK of this sheet)

Name of Plugging Contractor Bergman Drilling, Inc. 425 Union Center Wichita, Kansas  
Address 425 Union Center Building, Wichita, Kansas


STATE OF Kansas, COUNTY OF Sedgwick, ss.  
Harold Bergman (owner or operator) of the above-described well, being first duly sworn on oath, says: That I have knowledge of the facts, statements, and matters herein contained and the log of the above-described well as filed and that the same are true and correct. So help me God.

(Signature) Harold Bergman  
425 Union Center Bldg. Wichita, Kansas  
(Address)

SUBSCRIBED AND SWORN TO before me this 24th day of December, 1958

My commission expires October 15, 1962

Judith L. Palmer Notary Public.

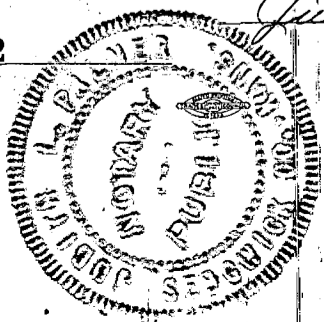

PLUGGING  
FILE SEC 33 T 12 R 18w  
BOOK PAGE 6 LINE 23

Date Started December 8, 1958  
Date Completed December 23, 1958

#1 Dumler 15-051-00346-00-00  
SW SW SE sec. 28-T12s-R18w  
Ellis County, Kansas

0- 210 Shale and Shells  
210- 655 Shale and Sand  
655-1055 Shale, Sand and Shells  
1055-1210 Sand and Shale  
1210-1415 Red Bed Shale  
1415-1455 Anhydrite  
1455-2310 Shale and Shells  
2310-2315 Shale and Lime  
2315-2985 Shale and Lime  
2985-3160 Shale and Shells  
3160-3473 Shale and Lime  
3473-3760 Lime  
3760-3803 Conglomerate  
3803 RTD

Elevation 2144 Kelly Bushing  
Anhydrite 1415 (-729) Drillers Top  
Howard Lime 3157 (-1013) Samples  
3164 (-1020) Electric Log  
Topeka Lime 3186 (-1042) Samples  
3193 (-1049) Electric Log  
Heebner Shale 3395 (-1251) Samples  
3401 (-1257) Electric Log  
Toronto Lime 3417 (-1273) Samples  
3423 (-1279) Electric Log  
Lansing KC 3444 (-1300) Samples  
3449 (-1305) Electric Log  
Base KC 3683 (-1539) Samples  
3684 (-1540) Electric Log  
Shale Cong. 3720 (-1576) Samples  
3723 (-1579) Electric Log  
Chert Cong. 3733 (-1589) Samples  
3735 (-1591) Electric Log  
Rotary TD 3803 (-1659) Samples  
3804 (1660) Electric Log

**AFFIDAVIT**

State of Kansas.....Sedgwick County

I, Harold Bergman, Vice-President, Do swear that the statements and matter herein contained are true to the best of my knowledge.

BERGMAN DRILLING, INC.

*Harold Bergman*  
Harold Bergman

Subscribed and sworn before me this 29<sup>th</sup> day of December, 1958.

My commission expires October 15, 1962

*Judith L. Palmer*  
Notary Public

PLUGGING  
FILE SEC 28 T 12 R 18W  
BOOK PAGE 6 LINE 23

