


WELL PLUGGING RECORD

15-051-23492-00-00

Give All Information Completely  
 Make Required Affidavit

COUNTY Ellis SEC. 16 TWP. 12S RGE. 19W E/W  
 Location as in quarters or footage from lines:

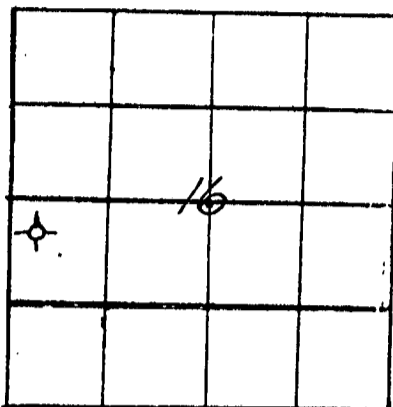

Locate Well  
 correctly on above  
 Section Platt.

Lease Owner Oxford Exploration Co.  
 Lease Name Pfeifer 16-12 Well No. 16-122  
 Office Address 1550 Denver Club Bldg. Denver, Colorado 80202  
 Character of Well (Completed as Oil, Gas or Dry Hole): D.H.(c)(L)  
 Date Well Completed 6-13-83  
 Application for plugging filed 6-13-83  
 Plugging commenced 6-13-83  
 Plugging completed 6-13-83  
 Reason for abandonment of well or producing formation \_\_\_\_\_

Was permission obtained from the Conservation Division or it's  
 Agent's before plugging was commenced? yes by Gilbert Schick

Name of Conservation Agent who supervised plugging of this well Gilbert Schick

Producing formation \_\_\_\_\_ Depth to top \_\_\_\_\_ bottom \_\_\_\_\_ T.D. 3885'

Show depth and thickness of all water, oil and gas formations.

OIL, GAS OR WATER RECORDS

Casing Record

Formation	Content	From	To	Size	Put in	Pulled Out
Surface	6 jts. 241'			8 5/8"	set @ 244'	

Describe in detail the manner in which the well was plugged, indicating where the mud fluid was placed and the method or methods used in introducing it into the hold. If cement or other plugs were used, state the character of same and depth placed, from \_\_\_\_\_ feet to \_\_\_\_\_ feet for each plug set.

Plugged w/180 sx., 50-50 posmix, 4% gel, 3% c.c.,  
 1st plug @ 3880', w/20 sx., 2nd plug @ 1550' w/20s x.  
 3rd plug @ 830' w/80 sx., 4th plug @ 300' w/40 sx.,  
 solid bridge plug from 0 to 40 w/100 sx., 10 sx., in  
 the rat hole, Started @ 9:30 a.m., completed @ 12:00 noon  
 State Plugger Gilbert Schick


RECEIVED  
 STATE CORPORATION COMMISSION

JUN 30 1983  
 06-30-1983  
 CONSERVATION DIVISION  
 Wichita, Kansas

(If additional description is necessary, use BACK of this sheet)  
 Name of Plugging Contractor Warrior Drilling Co., Rig #1

STATE OF Kansas COUNTY OF Sedgwick, ss.  
F.W. Shelton, Jr., (employee of owner) ~~xxx xxx xxx xxx xxx~~ of the  
 above-described well, being first duly sworn on oath, says: That I have knowledge of the  
 facts, statements, and matters herein contained and the log of the above-described well as  
 filed and that the same are true and correct. So help me God.  
 (Signature) F.W. Shelton, Jr.  
 (Address) Vice Pres.

SUBSCRIBED AND SWORN TO before me this 13th day of June, 19 83

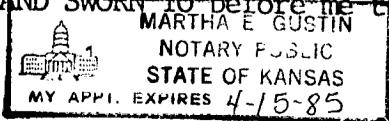

Martha E. Gustin  
 Martha E. Gustin Notary Public.

My Commission expires: \_\_\_\_\_