


WELL PLUGGING RECORD

Give All Information Completely
Make Required Affidavit
Mail or Deliver Report to:
Conservation Division
State Corporation Commission
212 North Market, Insurance Bldg.
Wichita, Kansas

Ellis County. Sec. 10 Twp. 12 Rge. ~~(E)~~ 19(W)

Location as "NE/CNW/SW" or footage from lines. SW SW NW
Lease Owner Icer Adois
Lease Name Schmidt Well No. 1
Office Address Box 27 Russell, Kansas
Character of Well (completed as Oil, Gas or Dry Hole) dry hole
Date well completed April 4 19 60
Application for plugging filed April 5 19 60
Application for plugging approved 19
Plugging commenced 11:50 am April 4 19 60
Plugging completed 4:00 pm " " 19 60
Reason for abandonment of well or producing formation dry hole

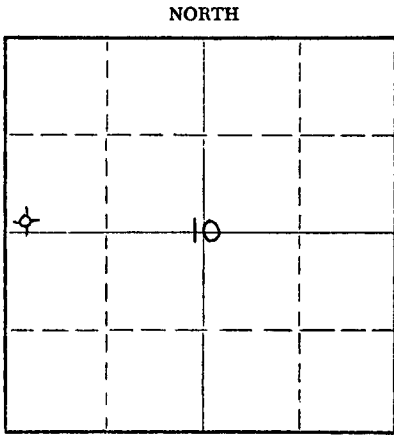

Locate well correctly on above Section Plat

If a producing well is abandoned, date of last production 19
Was permission obtained from the Conservation Division or its agents before plugging was commenced? yes

Name of Conservation Agent who supervised plugging of this well Mr. Eldon Petty
Producing formation Depth to top Bottom Total Depth of Well 3874 Feet
Show depth and thickness of all water, oil and gas formations.

OIL, GAS OR WATER RECORDS

CASING RECORD

FORMATION	CONTENT	FROM	TO	SIZE	PUT IN	PULLED OUT
				8 5/8"	191'	none

Describe in detail the manner in which the well was plugged, indicating where the mud fluid was placed and the method or methods used in introducing it into the hole. If cement or other plugs were used, state the character of same and depth placed, from feet to feet for each plug set.

Bottom plug set at 600', 20 sacks of cement through drill pipe, 1/2 sack of hulls and plug at 180', 15 sacks of cement through drill pipe, 1/2 sack of hulls and plug at 40', 10 sacks of cement.

RECEIVED
STATE CORPORATION COMMISSION
APR 11 1960
04-11-1960
CONSERVATION DIVISION
Wichita, Kansas

(If additional description is necessary, use BACK of this sheet)
Name of Plugging Contractor Triangle Drilling, Inc.
Address Box 287 Russell, Kansas

STATE OF Kansas, COUNTY OF Barton, ss.
Donald D. Vaughan (employee of owner) or ~~owner or operator~~ of the above-described well, being first duly sworn on oath, says: That I have knowledge of the facts, statements, and matters herein contained and the log of the above-described well as filed and that the same are true and correct. So help me God.

(Signature) Donald D. Vaughan
Box 619 Great Bend, Kansas
(Address)

SUBSCRIBED AND SWORN TO before me this 5th day of April, 19 60.
Donna Lea Foelgner
Donna Lea Foelgner Notary Public.

My commission expires May 11, 1963

WELL LOG

OPERATOR Icer Addis
 CONTRACTOR Triangle Drilling, Inc.
 FARM #1 Schmidt
 LOCATION SW SW NW of Section 10-12-19W
 Ellis County, Kansas
 ELEVATION 2240 KB
 SURFACE PIPE 8 5/8" cemented @ 191* w/135 sacks HA5 cement
 PRODUCTION D & A
 COMMENCED 3-24-60
 COMPLETED 4-4-60

<u>FORMATION</u>	<u>DEPTH</u>
Surface clay and sand	75
Shale	750
Sand	820
Shale	905
Shale and sand	1015
Sand	1245
Red bed	1556
Anhydrite	1603
Shale and shells	2085
Limestone and shale	2440
Limestone	2695
Sand	2710
Limestone and shale	3242
Limestone	3505
Shale	3513
Limestone	3757
Limestone and shale	3819
Chert Conglomerate	3866
Dolomite	3874


FORMATION TOPS

Anhydrite	1556 (/ 684)
Topeka	3242 (-1002)
Heebner	3473 (-1233)
Toronto	3491 (-1251)
Lansing	3513 (-1273)
Base Kansas City	3757 (-1517)
Chert Conglomerate	3819 (-1579)
Arbuckle	3866 (-1626)
RTD	3874 (-1634)

A F F I D A V I T

STATE OF KANSAS, COUNTY OF BARTON, SS.

I, Donald D. Vaughan, of the TRIANGLE DRILLING, INC., being first duly sworn on oath, state; That I have knowledge of the facts, statements and matters herein contained and that the same are true and correct.

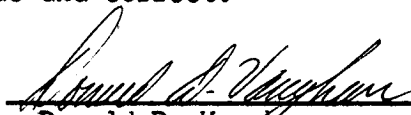

 Donald D. Vaughan

Subscribed and sworn to before me this 5th day of April, 1960

My commission expires: May 11, 1963.



 Donna Lea Foelgner, Notary Public

RECEIVED
 STATE COMMISSION
 APR 11 1960
 04-11-1960
 CONSERVATION DIVISION
 Wichita, Kansas