

STATE OF KANSAS
 STATE CORPORATION COMMISSION
 200 Colorado Derby Bldg.
 Wichita, Kansas 67202


Form CP-4
 Rev. 12-15-80

15-051-23530-00-00

WELL PLUGGING RECORD

Give All Information Completely
 Make Required Affidavit

COUNTY Ellis SEC. 20 TWP. 12S RGE. 19 E/W
 Location as in quarters or footage from lines:
330' from the North line & 330' from the West Line

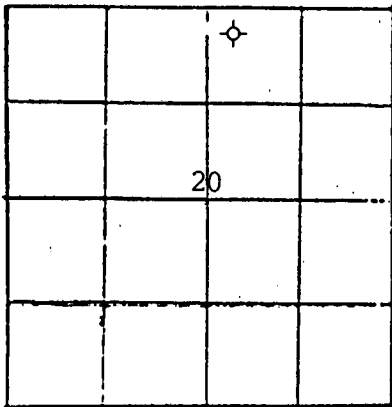

Lease Owner Gear Petroleum Company, Inc.
 Lease Name Kreutzer Well No. 1-20
 Office Address 300 Sutton Place, Wichita, Ks. 67202
 Character of Well (Completed as Oil, Gas or Dry Hole): D/A(c)(c)
 Date Well Completed 7-25-83
 Application for plugging filed 7-25-83
 Plugging commenced 7-25-83
 Plugging completed 7-26-83
 Reason for abandonment of well or producing formation D/A

Locate Well
 correctly on above
 Section Platt.

Was permission obtained from the Conservation Division or it's
 Agent's before plugging was commenced? yes

Name of Conservation Agent who supervised plugging of this well _____

Producing formation _____ Depth to top _____ bottom _____ T.D. 3825'

Show depth and thickness of all water, oil and gas formations.

OIL, GAS OR WATER RECORDS Casing Record

Formation	Content	From	To	Size	Put in	Pulled Out
				8 5/8"	274.30'	-0-

Describe in detail the manner in which the well was plugged, indicating where the mud
 fluid was placed and the method or methods used in introducing it into the hold. If cement
 or other plugs were used, state the character of same and depth placed, from _____ feet
 to _____ feet for each plug set.

- 1st plug set @ 3800' w/20 sacks
- 2nd plug set @ 1570' w/20 sacks
- 3rd plug set @ 700' w/80 sacks
- 4th plug set @ 300' w/40 sacks
- plug from 40' to surface w/10 sacks
- 10 sacks in rathole

cement was 50/50 pozmix 6% gel 2% cc

(If additional description is necessary, use BACK of this sheet)

Name of Plugging Contractor Allied Cementing
P. O. Box 31, Russell, Kansas 67665

STATE OF Kansas COUNTY OF Sedgwick, ss.
Jim Thatcher, Drilling & Production Mgr (employee of owner) or (owner or operator) of the
 above-described well, being first duly sworn on oath, says: That I have knowledge of the
 facts, statements, and matters herein contained and the log of the above-described well as
 filed and that the same are true and correct. (So help me God.)



Jim Thatcher (Signature)
300 Sutton Place, Wichita, KS
 (Address) 67202

SUBSCRIBED AND SWORN TO before me this 16th day of August, 19 83

Helen L. Coyer
 Notary Public.

My Commission expires: April 1, 1986

STATE OF KANSAS
 STATE CORPORATION COMMISSION
 200 Colorado Derby Bldg.
 Wichita, Kansas 67202

Form CP-4
 Rev. 12-15-80

WELL PLUGGING RECORD

15-051-23530-00-00

Give All Information Completely
 Make Required Affidavit

COUNTY Ellis SEC. 20 TWP. 12S RGE. 19 E/W
 Location as in quarters or footage from lines:
330' from the North line & 330' from the West Line

		+	
	20		

Lease Owner Gear Petroleum Company, Inc.
 Lease Name Kreutzer Well No. 1-20
 Office Address 300 Sutton Place, Wichita, Ks. 67202
 Character of Well (Completed as Oil, Gas or Dry Hole): D/A(x)
 Date Well Completed 7-25-83
 Application for plugging filed 7-25-83
 Plugging commenced 7-25-83
 Plugging completed 7-26-83
 Reason for abandonment of well or producing formation D/A

Locate Well
 correctly on above
 Section Platt.

Was permission obtained from the Conservation Division or it's
 Agent's before plugging was commenced? yes

Name of Conservation Agent who supervised plugging of this well _____
 Producing formation _____ Depth to top _____ bottom _____ T.D. 3825'

Show depth and thickness of all water, oil and gas formations.

OIL, GAS OR WATER RECORDS

Casing Record

Formation	Content	From	To	Size	Put in	Pulled Out
				8 5/8"	274.30'	-0-

Describe in detail the manner in which the well was plugged, indicating where the mud
 fluid was placed and the method or methods used in introducing it into the hold. If cement
 or other plugs were used, state the character of same and depth placed, from _____ feet
 to _____ feet for each plug set.

- 1st plug set @ 3800' w/20 sacks
- 2nd plug set @ 1570' w/20 sacks
- 3rd plug set @ 700' w/80 sacks
- 4th plug set @ 300' w/40 sacks
- plug from 40' to surface w/10 sacks
- 10 sacks in rathole


cement was 50/50 pozmix 6% gel 2% cc

(If additional description is necessary, use BACK of this sheet)

Name of Plugging Contractor Allied Cementing
P. O. Box 31, Russell, Kansas 67665

STATE OF Kansas COUNTY OF Sedgwick, ss.

Jim Thatcher, Drilling & Production Mgr (employee of owner) or (owner or operator) of the
 above-described well, being first duly sworn on oath, says: That I have knowledge of the
 facts, statements, and matters herein contained and the log of the above-described well as
 filed and that the same are true and correct. So help me God.

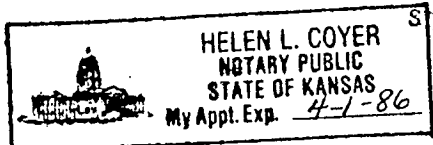

RECEIVED
 STATE CORPORATION COMMISSION
 08-17-1983
 AUG 17 1983

Jim Thatcher
300 Sutton Place, Wichita, KS
 (Address) 67202

SUBSCRIBED AND SWORN TO before me this 16th day of August, 19 83
Wichita, Kansas

Helen L. Coyer
 Notary Public.

My Commission expires: April 1, 1986