


STATE OF KANSAS
STATE CORPORATION COMMISSION

Form CP-4

Give All Information Completely
Make Required Affidavit
Mail or Deliver Report to:
Conservation Division
State Corporation Commission
212 No. Market
Wichita, Kansas

WELL PLUGGING RECORD

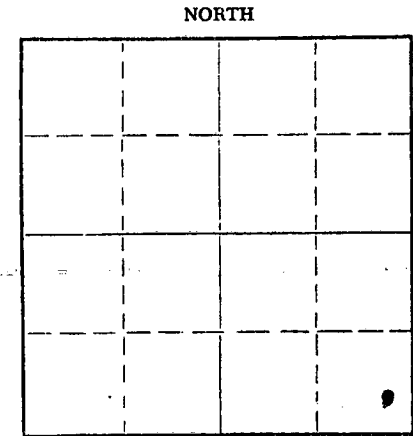

Books County, Sec. 2 Twp. 10 Rge. 20 (E) (W)

Location as "NE/CNW/SW" or footage from lines SE SE SE

Lease Owner The Stone Brown Co.

Lease Name Coddington Well No. 1

Office Address 1000 SW Second Plainville Kans

Character of Well (completed as Oil, Gas or Dry Hole) Oil

Date well completed 12 month 1973

Application for plugging filed 12-9 1974

Application for plugging approved 12-16 1974

Plugging commenced 12-23 1974

Plugging completed 12-30 1974

Reason for abandonment of well or producing formation Well did not make any

oil

If a producing well is abandoned, date of last production _____ 19____

Was permission obtained from the Conservation Division or its agents before plugging was commenced? Yes

Name of Conservation Agent who supervised plugging of this well Leo Massey

Producing formation Osage Depth to top 3780 Bottom 3808 Total Depth of Well 3808 Feet

Show depth and thickness of all water, oil and gas formations.

OIL, GAS OR WATER RECORDS

CASING RECORD

FORMATION	CONTENT	FROM	TO	SIZE	PUT IN	PULLED OUT
	Surface pipe	0	172	8 5/8"	172	None
	Long string	0	3788	5 1/2"	3788.5	1595
<u>Osage</u>	<u>oil & water</u>	<u>3780</u>	<u>3808</u>			

Describe in detail the manner in which the well was plugged, indicating where the mud fluid was placed and the method or methods used in introducing it into the hole. If cement or other plugs were used, state the character of same and depth placed, from _____ feet to _____ feet for each plug set.

Pushed plug from 0 to 3750 dumped 4 sacks of cement. pushed plug from 0 to 3400 dumped 10 gal rock & 15 gal sand dumped 4 sacks cement. Loaded hole with water. Shot pipe off at 1595 and pulled out of hole. 7 sized & pumped down 8 5/8" casing 20 sacks fell with 3 bulls 1730 to 810 - 70 sacks of Poz 6 7/8 810-600 10 sacks fell & plug 600-200 50 sacks of Poz from 200 to base of casing.

RECEIVED
STATE CORPORATION COMMISSION
1-15-75
JAN 15 1975

CONSERVATION DIVISION
Wichita, Kansas

(If additional description is necessary, use BACK of this sheet)
Name of Plugging Contractor Charlie Crow Drilling Company
Address Box 706 Hays Kansas

STATE OF Kansas, COUNTY OF Books, ss.
Thomas E. Brown (employee of owner) or (owner or operator) of the above-described well, being first duly sworn on oath, says: That I have knowledge of the facts, statements, and matters herein contained and the log of the above-described well as filed and that the same are true and correct. So help me God.

(Signature) Thomas E. Brown

1000 SW Second Plainville Kans 67663
(Address)

SUBSCRIBED AND SWORN TO before me this 13th day of January, 1975

My Commission Expires May 16, 1978

My commission expires _____

