


15-163-02018-0000

STATE OF KANSAS  
STATE CORPORATION COMMISSION

Form CP-4

Give All Information Completely  
Make Required Affidavit  
Mail or Deliver Report to:  
Conservation Division  
State Corporation Commission  
212 No. Market  
Wichita, Kansas

WELL PLUGGING RECORD

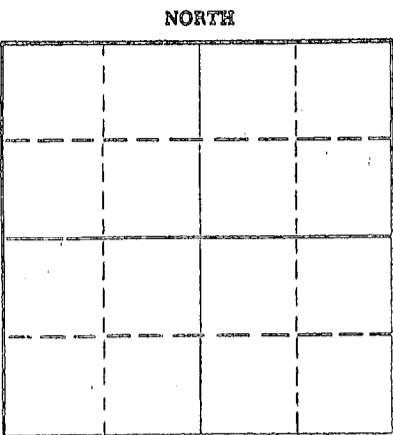

Locate well correctly on above  
Section Plat

Rocks \_\_\_\_\_ County, Sec. 4 Twp. 16S Rge. 20E (E) \_\_\_\_\_ (W) \_\_\_\_\_  
Location as "NE/CNW/SW" or footage from lines C E 1/2 NE SW  
Lease Owner Specter Pipe & Supply Company, Inc.  
Lease Name Towns Well No. 1  
Office Address Russell, Kansas  
Character of Well (completed as Oil, Gas or Dry Hole) oil  
Date well completed 10-9-51 \_\_\_\_\_ 19\_\_\_\_  
Application for plugging filed April 20, 1970 \_\_\_\_\_ 19\_\_\_\_  
Application for plugging approved April 21, 1970 \_\_\_\_\_ 19\_\_\_\_  
Plugging commenced April, 22, 1970 \_\_\_\_\_ 19\_\_\_\_  
Plugging completed April, 24, 1970 \_\_\_\_\_ 19\_\_\_\_  
Reason for abandonment of well or producing formation failure to produce profitably  
If a producing well is abandoned, date of last production \_\_\_\_\_ 19\_\_\_\_  
Was permission obtained from the Conservation Division or its agents before plugging was commenced? Yes

Name of Conservation Agent who supervised plugging of this well Leo Massey  
Producing formation Arbuckle Depth to top 3829' Bottom 3836 ft. Total Depth of Well 3839' Feet  
Show depth and thickness of all water, oil and gas formations.

OIL, GAS OR WATER RECORDS

CASING RECORD

FORMATION	CONTENT	FROM	TO	SIZE	PUT IN	PULLED OUT
				8 5/8" OD	141 ft.	none
				5 1/2" OD	3836 ft.	600

Describe in detail the manner in which the well was plugged, indicating where the mud fluid was placed and the method or methods used in introducing it into the hole. If cement or other plugs were used, state the character of same and depth placed, from \_\_\_\_\_ feet to \_\_\_\_\_ feet for each plug set.


Plugged, back with sand to 3800-feet, dumped 5- sacks - Cement, Pumped 3- sacks hulls, Pumped 15- sacks mud, and 50- sacks - Cement.  
5- sacks of Mud and 50- sacks Cement.

RECEIVED  
STATE CORPORATION COMMISSION  
MAY 1 1970  
CONSERVATION DIVISION  
Wichita, Kansas

(If additional description is necessary, use BACK of this sheet)  
Name of Plugging Contractor LYNCH CASING PULLING COMPANY. NO. 457  
Address R. Rt. 4 GREAT BEND, KANSAS. 67530

STATE OF Kansas COUNTY OF Russell, ss.  
Specter Pipe & Supply, Inc. (employee of owner) or (owner or operator) of the above-described well, being first duly sworn on oath, says: That I have knowledge of the facts, statements, and matters herein contained and the log of the above-described well as filed and that the same are true and correct. So help me God.

(Signature) [Signature]  
(Address) [Address]

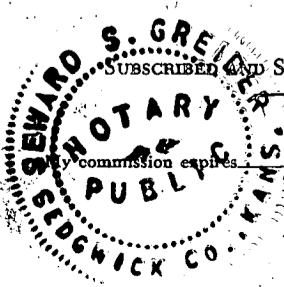

SUBSCRIBED AND SWORN TO before me this 1st day of May, 1970  
Nov. 5, 1971  
[Signature]  
Notary Public.