


STATE OF KANSAS
STATE CORPORATION COMMISSION

WELL PLUGGING RECORD

Give All Information Completely
Make Required Affidavit
Mail or Deliver Report to
Conservation Division
State Corporation Comm.
245 North Water
Wichita, KS 67202

Rooks County, Sec. 3 Twp. 10 Rge. 20 E/W
Location as "NE/CNW $\frac{1}{4}$ SW $\frac{1}{4}$ " or footage from lines
SE/4

Lease Owner J. B. Collins
Lease Name Nutsch Well No. 1
Office Address 1007 Cody Ave. Suite A, Hays, KS 67601
Character of Well (Completed as Oil, Gas or Dry Hole)
Dry Hole

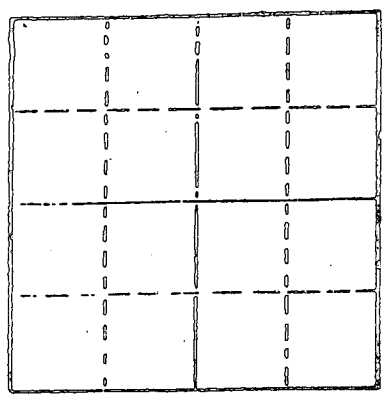

Locate well correctly on above
Section Plot

Date Well completed 2-11 1981
Application for plugging filed 2-11 1981
Application for plugging approved 2-11 1981
Plugging commenced 2-11 1981
Plugging completed 2-11 1981
Reason for abandonment of well or producing formation

If a producing well is abandoned, date of last production 19

Was permission obtained from the Conservation Division or its agents before plugging was commenced? Yes

Name of Conservation Agent who supervised plugging of this well Marion Schmidt
Producing formation Depth to top Bottom Total Depth of Well 3852'
Show depth and thickness of all water, oil and gas formations.

OIL, GAS OR WATER RECORDS

CASING RECORD

FORMATION	CONTENT	FROM	TO	SIZE	PUT IN	PULLED OUT
				8 5/8"	168'	-0-

Describe in detail the manner in which the well was plugged, indicating where the mud fluid was placed and the method or methods used in introducing it into the hold. If cement or other plugs were used, state the character of same and depth placed, from feet to feet for each plug set.

- 1st plug was set @ 870' with 65 sacks cement
- 2nd plug was set @ 210' with 30 sacks cement
- 3rd plug was set @ 40' with 10 sacks cement

(If additional description is necessary, use BACK of this sheet)

Name of Plugging Contractor Dreiling Oil, Inc. Victoria, KS 67671

STATE OF KANSAS COUNTY OF ELLIS, ss.

I, Joseph A. Hess, Secretary Treasurer of Dr. g. (Employee of owner) or (owner or operator) of the above-described well, being first duly sworn on oath, says: That I have knowledge of the facts, statements, and matters herein contained and the log of the above-described well as filed and that the same are true and correct. So help me God.

(Signature) Joseph A. Hess
JOSEPH A. HESS, Hays, KS 67601
(Address)

SUBSCRIBED AND SWORN TO before me this 17th day of February, 1981

Patty Dreiling
Patty Dreiling Notary Public.

My commission expires August 30, 1982



RECEIVED
STATE CORPORATION COMMISSION
2-18-81
FEB 18 1981

CONSERVATION DIVISION
Wichita, Kansas

DREILING OIL, INC.

Victoria, Kansas 67671

15-163-21235-0000

WELL LOG

Company J. B. Collins
1007 Cody Ave. Suite A
Hays, KS 67601

Sec. 3 Twp. 10 Rng. 20W

Farm Nutsch No. 1

Location SE/4

Total Depth 3852'

County Rooks

Comm. 2-4-81 Comp. 2-11-81

Elevation: 2366' K. B.

Contractor Dreiling Oil, Inc.
Rt. #1
Victoria, KS 67671

RT 2363' D. F.

KCC 2361' G. B.

Casing Record

168' - 8 5/8"

Cement Record

130 sacks cement

Production:

D & A

Figures Indicate Bottom of Formations

0'	60'	Top Soil & Sand
60'	95'	Sand
95'	173'	Shale
173'	247'	Shale & Sand
247'	771'	Shale
771'	1226'	Sand & Shale
1226'	1355'	Sand
1355'	1435'	Sand
1435'	1744'	Red Bed & Shale
1744'	1784'	Anhy.
1784'	1890'	Shale
1890'	2340'	Shale
2340'	2516'	Shale & Lime
2516'	2738'	Lime & Shale
2738'	2940'	Lime & Shale Streaks
2940'	3097'	Shale & Lime
3097'	3365'	Shale & Lime
3365'	3445'	Lime
3445'	3530'	Lime
3530'	3603'	Lime
3603'	3685'	Lime
3685'	3777'	Lime
3777'	3852'	Lime - Arbuckle
3852'	T, D.	

STATE OF KANSAS)
)ss
COUNTY OF ELLIS)

RECEIVED
COMMISSION
MAR 20 1981
CONSERVATION DIVISION
Wichita, Kansas

I, Joseph A. Hess, Secretary Treasurer of Dreiling Oil, Inc., upon oath states that the above and foregoing is a true and correct copy from the Daily Drilling Report from the Nutsch #1.

Joseph A. Hess
JOSEPH A. HESS

Subscribed and sworn to before me this 17th day of February, 1981:

Patty Dreiling
Patty Dreiling Notary Public

My commission expires: August 30, 1982.

