

15-163-04082-0000


STATE OF KANSAS
STATE CORPORATION COMMISSION

WELL PLUGGING RECORD

Give All Information Completely
Make Required Affidavit
Mail or Deliver Report to:
Conservation Division
State Corporation Commission
800 Bittling Building
Wichita, Kansas

Rooks County, Sec. 3 Twp. 10S Rge. (E) 20 (W)

Location as "NE/CNW $\frac{1}{4}$ SW $\frac{1}{4}$ " or footage from lines W/2 W/2 SW $\frac{1}{4}$
Lease Owner Heathman Drilling Co., Inc.
Lease Name H. NUTSCH Well No. 2
Office Address 509 Orpheum Bldg., Wichita, Kansas
Character of Well (completed as Oil, Gas or Dry Hole) dry hole
Date well completed 3-24-50 19
Application for plugging filed 3-24-50 19
Application for plugging approved 3-24-50 19
Plugging commenced 3-24-50 19
Plugging completed 3-24-50 19
Reason for abandonment of well or producing formation ----

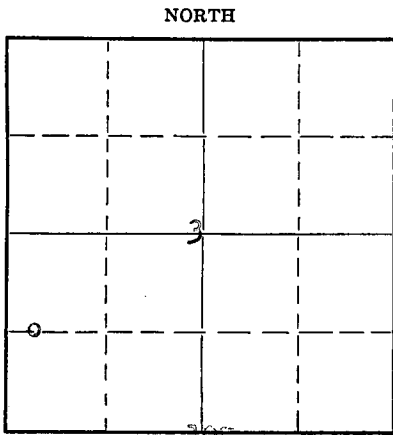

Locate well correctly on above
Section Plat

If a producing well is abandoned, date of last production 19
Was permission obtained from the Conservation Division or its agents before plugging was commenced? yes

Name of Conservation Agent who supervised plugging of this well Eldon Petty, Hays, Kansas
Producing formation none Depth to top --- Bottom --- Total Depth of Well 3900 Feet
Show depth and thickness of all water, oil and gas formations.

OIL, GAS OR WATER RECORDS

CASING RECORD

Formation	Content	From	To	Size	Put In	Pulled Out
none	---	---	---	3 jts. (135') 8-5/8"	surface casing	
					cemented at 129' w/100 sacks Lone Star cement add 1 sack Cal. Chlor.	
				none pulled out.		

Describe in detail the manner in which the well was plugged, indicating where the mud fluid was placed and the method or methods used in introducing it into the hole. If cement or other plugs were used, state the character of same and depth placed, from ----- feet to ----- feet for each plug set.

Filled hole with heavy mud and put bottom plug at 130' w/15 sacks cement; filled hole to 40' with heavy mud and put 10 sacks cement on top hole plug.

3-28-50

(If additional description is necessary, use BACK of this sheet)

Correspondence regarding this well should be addressed to Heathman Drilling Co., Inc.,
Address 509 Orpheum Bldg., Wichita 2, Kansas

STATE OF Kansas, COUNTY OF Sedgwick, ss.
H. D. Shreve (employee of owner) for (owner or operator) of the above-described well,

being first duly sworn on oath, says: That I have knowledge of the facts, statements, and matters herein contained and the log of the above-described well as filed and that the same are true and correct. So help me God. HEATHMAN DRILLING CO., INC.

(Signature) H. D. Shreve By: H. D. Shreve

509 Orpheum Bldg., Wichita, Kansas
(Address)

SUBSCRIBED AND SWORN TO before me this 27th day of March, 1950.

My commission expires June 28, 1952.

D. Marjorie Mott
Notary Public.

22-7377-8 4-49-10M

FILE SEC 3 T10 R20
BOOK PAGE 144 LINE 43

H. NUTSCH # 2 WELL

Location: W/2 W/2 SW/4 Sec. 3-10E-20W

Operator: Heathman Drilling Co., Inc.

Contractor: Heathman Drilling Co., Inc.

Surface Casings: 3 jts. (135') 8-5/8" cemented
 @ 129' w/100 sacks Lone Star
 cement and 1 sack Cl. Chloride.

Oil Strings: None run.
 Dry and abandoned 3-24-50

Spudded: 3-14-50
 Rotary Completion Date: 3-24-50
 Elevation: 2204 Gr; 2207 DF; 2209 KB
 Rotary Total Depth: 3900'

T O P S. (KB)

Anhydrite	1692 (4517)
Heebner	3450 (-1241)
Lansing-Kansas City	3490 (-1281)
Base Kansas City	3720
Shale Conglomerate	3769 (-1560)
Shale and clay conglomerate	to 3838 (-1628)
Chert Conglomerate	to 3875 (-1666)
Arbuckle Top	3875 (-1666)
Total Depth	3900'

L O G

(Figures indicate bottom of formation)

Sand and shale	0 to 100
Shale	200
Shale	750
Sand and shale	1180
Sand	1430
Shale and shells	1692
Anhydrite	1727
Shale and shells	2475
Shale and lime	3288
Lime	3380
Lime and shale	3507
Lime	3722
Lime and shale	3772
Conglomerate and chert	3875
Dolomite	3895
Lime (cherty)	3900'
Total Depth	3900'

The undersigned, H. D. Shreve, of the Heathman Drilling Co., Inc., hereby certifies that the above log is a true and correct log of the formations encountered in the drilling of the above well as reflected by the Daily Drilling Reports.

HEATHMAN DRILLING CO., INC.

BY: H. D. Shreve
H. D. Shreve

Subscribed and sworn to before
me this 27th day of March 1950.

Margaret Matt
Notary Public

My commission expires: June 28, 1952.

