

STATE OF KANSAS
STATE CORPORATION COMMISSION

WELL PLUGGING RECORD

Give All Information Completely
Make Required Affidavit
Mail or Deliver Report to:
Conservation Division
State Corporation Commission
800 Bittling Building
Wichita, Kansas

Rooks County, Sec. 3 Twp. 10 Rge. 20 ~~xxx~~ (W)

Location as "NE/CNW 1/4 SW 1/4" or footage from lines NE/4 NW/4 NW/4

Lease Owner Heathman & Co.

Lease Name H. NUTSCH Well No. 1

Office Address 509 Orpheum Building, Wichita, Kansas

Character of Well (completed as Oil, Gas or Dry Hole) Dry hole

Date well completed 12-9 19 51

Application for plugging filed 12-9 19 51

Application for plugging approved 12-9 19 51


Plugging commenced 12-9 19 51

Plugging completed 12-9 19 51

Reason for abandonment of well or producing formation Dry hole

If a producing well is abandoned, date of last production ----- 19-----

Was permission obtained from the Conservation Division or its agents before plugging was commenced? yes

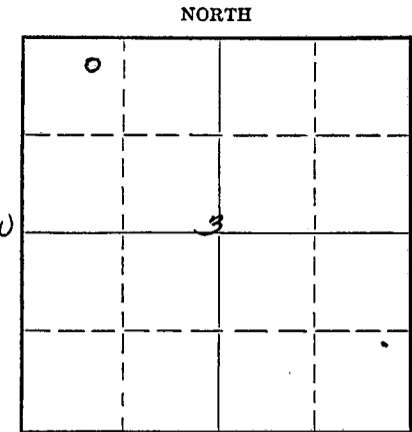

Locate well correctly on above Section Plat

Name of Conservation Agent who supervised plugging of this well Eldon Petty, Box 326, Hays, Kansas

Producing formation ----- Depth to top ----- Bottom ----- Total Depth of Well 3930 Feet

Show depth and thickness of all water, oil and gas formations.

OIL, GAS OR WATER RECORDS

CASING RECORD

Formation	Content	From	To	Size	Put In	Pulled Out
None				8-5/8" (5 jts.)	152.28'	
				cemented at 151' w/110 sacks cement and 1 sack C.C.		
						None pulled

Describe in detail the manner in which the well was plugged, indicating where the mud fluid was placed and the method or methods used in introducing it into the hole. If cement or other plugs were used, state the character of same and depth placed, from ----- feet to ----- feet for each plug set.

Filled hole with mud; set bottom plug at 150';
put 1 sack hulls on top and 15 sacks cement;
set top plug at 40' down; put 1/2 sack hulls
and 10 sacks cement, 12-9-51.

12-15-51
DEC 15 1951

(If additional description is necessary, use BACK of this sheet)

Name of Plugging Contractor Heathman & Co.

Address 509 Orpheum Building, Wichita, Kansas

STATE OF Kansas, COUNTY OF Sedgwick, ss. and Jack H. Heathman (employee of contractor) (owner or operator) of the above-described well,

being first duly sworn on oath, says: That I have knowledge of the facts, statements, and matters herein contained and the log of the above-described well as filed and that the same are true and correct. So help me God.

(Signature) Jack H. Heathman

509 Orpheum Building, Wichita, Kansas (Address)

SUBSCRIBED AND SWORN to before me this 13th day of December, 1951.

My commission expires Feb. 29, 1955. Mary L. Lawrence, Notary Public.



PLUGGING
FILE SEC 3 T 10 20W
BOOK PAGE 131 LINE 7

H. NUTSCH WELL No. 1

Location:	NE/4 NW/4 NW/4 Sec. 3-10S-20W Rooks County, Kansas	Date Spudded:	11-28-51
Operator:	Heathman & Co.	Rotary Completed:	12-9-51
Contractor:	Heathman & Co.	Elevation:	2249 Gr; 2252 DF 2254 KB
Surface Casing:	5 jts. 8-5/8" (152.28') set @ 151' w/110 sacks cement and 1 sack C.C.	Rotary Total Depth:	3930'
Oil String:	None - D & A		

GEOLOGICAL TOPS (KB)

Topeka	3296 (-1042)
Heebner	3500 (-1246)
Lansing-Kansas City	3539 (-1285)
Base of Kansas City	3766 (-1512)
Shale Conglomerate	3807 (-1553)
Chert Conglomerate	3828 (-1574)
Simpson Shale	3862 (-1608)
Arbuckle	3880 (-1626)
Rotary Total Depth	3930 (-1676)

L O G

(Figures indicate bottom of formation)

Shale and sand	0 to 40
Sand and shale	155
Shale and sand	1300
Sand	1455
Sand and shale	1760
Shale and shells	2336
Lime and shale	2520
Shale and lime	2659
Lime and shale	2725
Shale and lime	2885
Shale	3078
Shale and shells	3160
Shale and lime	3241
Lime and shale	3930
Total Depth	3930

The undersigned, H. D. Shreve, hereby certifies that the above log is a true and correct log of the formations encountered in drilling the above noted well as reflected by the Daily Drilling Reports.

HEATHMAN & CO.

By *H. D. Shreve*
Partner

Subscribed and sworn to
before me this 13th day of
December 1951.

Mary L. Lawrence
Notary Public
My commission expires:
My Commission Expires Feb. 28, 1955

3-1-52-20-2
12/13/51-7