

15-163-60394-0000

STATE OF KANSAS
STATE CORPORATION COMMISSION

WELL PLUGGING RECORD

Give All Information Completely
Make Required Affidavit
Mail or Deliver Report to:
Conservation Division
State Corporation Commission
800 Bittling Building
Wichita, Kansas

Rooks County, Sec. 4 Twp 10S Rge. 20 ~~20E~~ (W)

Location as "NE/CNW $\frac{1}{4}$ SW $\frac{1}{4}$ " or footage from lines SW $\frac{1}{4}$ SW $\frac{1}{4}$ SW $\frac{1}{4}$

Lease Owner Heathman Drilling Co., Inc., et al

Lease Name TOWNS Well No. 1

Office Address 509 Orpheum Building, Wichita, Kansas

Character of Well (completed as Oil, Gas or Dry Hole) Dry hole

Date well completed 7-3-1950

Application for plugging filed 7-7-1950

Application for plugging approved 7-8-1950


Plugging commenced 7-8-1950

Plugging completed 7-15-1950

Reason for abandonment of well or producing formation upon drilling in and making 3' new hole - swabbed all water; no shows of oil.

If a producing well is abandoned, date of last production

Was permission obtained from the Conservation Division or its agents before plugging was commenced? yes

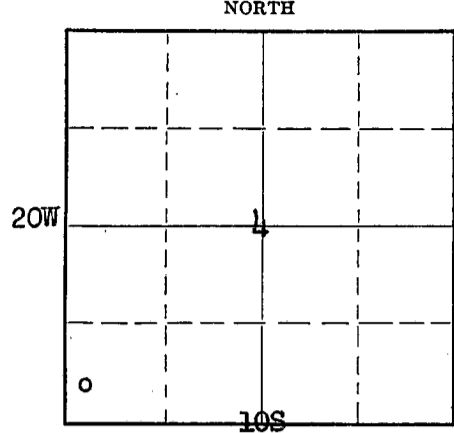

Locate well correctly on above Section Plat

Name of Conservation Agent who supervised plugging of this well

Producing formation --- Depth to top --- Bottom --- Total Depth of Well 3788' Feet

Show depth and thickness of all water, oil and gas formations. 3791' Cable Tool

OIL, GAS OR WATER RECORDS

CASING RECORD

Formation	Content	From	To	Size	Put In	Pulled Out
Arbuckle	water	3786	3788 T.D. rotary 3791 T.D., cable tool			
				8-5/8"	135'	none
				5-1/2"	3787 $\frac{1}{2}$ '	3150

Describe in detail the manner in which the well was plugged, indicating where the mud fluid was placed and the method or methods used in introducing it into the hole. If cement or other plugs were used, state the character of same and depth placed, from --- feet to --- feet for each plug set.

Crushed rock from 3791 to 3780. 4 Sacks Cement from 3780 to 3750
Pumped hole full of rotary mud set rock bridge from 175 to 165
Run 15 sacks cement filled to 90 put in rock bridge from 90' to 85'
Filled hole with mud to 45' Rock bridge from 45' to 40'
Run 8 sacks cement. Filled hole to top

RECEIVED
COP 7-27-50
JUL 27 1950
STATE OF KANSAS
CORPORATION COMMISSION

(If additional description is necessary, use BACK of this sheet)
Correspondence regarding this well should be addressed to Heathman Drilling Co., Inc.
Address 509 Orpheum Bldg., Wichita, Kansas

STATE OF Kansas COUNTY OF Russell, ss.
Bookkeeper (wife of owner) (employee of owner) or (owner or operator) of the above-described well,
being first duly sworn on oath, says: That I have knowledge of the facts, statements, and matters herein contained and the log of the above-described well as filed and that the same are true and correct. So help me God.

(Signature) Mrs. V. B. Shumaker
Russell, Mo (Address)

SUBSCRIBED AND SWORN to before me this 22nd day of July, 1950
My commission expires Dec 1, 1951
Ethel Coody Notary Public.



22-7377-8 4-49-10M

PLUGGING
FILE SEC 4 T 10 R 20W
BOOK PAGE 14 LINE 41

YOUNG NO. 1 WELL

LOCATION: SW/4 NW/4 SE/4 Sec. 10-105-20W
Reeks County, Kansas

CONTRACTOR: Heathman Drilling Co., Inc.

OPERATOR: Heathman Drilling Co., Inc.

SURFACE CASING: 4 jts. 8-5/8" (140.28) cemented
@ 135' w/100 sacks cement and
1 sack Cal. Chloride.

OIL STRINGS: 221 jts. 5 1/2" OD 8 rd. lhd. 11/2" H-40 JAL
cemented @ 3787 1/2' w/100 sacks Ash Grove.

SPUNDED: 6-22-50

COMPLETED: 7- 3-50

ELEVATION: 2190 KB

TOTAL DEPTH: 3788'

T O P S

Anhydrite	1685 (+ 505)
Topoka	3223 (-1033)
Beckner	3426 (-1236)
Lansing-K.C.	3466 (-1276)
Base Kansas City	3689 (-1499)
Shale Conglomerate	3723 (-1533)
Chert Conglomerate	3732 (-1542)
Notched Simpson	3760 (-1570)
Simpson	3762 (-1572)
Arbuckle	3784 (-1594)
Rotary Total Depth	3788 (-1598)

L O S

(Figures indicate bottom of formation)

Shale	0 to 136
Shale	310
Shale and shells	881
Shale and sand	1085
Shale and lime	1170
Sand	1365
Shale	1685
Anhydrite	1724
Shale and shells	2358
Shale and lime	2964
Shale	3040
Shale and lime	3222
Lime	3387
Lime and shale	3454
Lime	3732
Conglomerate	3760
Lime, chert and shale	3788
Total Depth	3788'

DRILLING-IN INFORMATION

Drilled plug; cleaned out to T.D.
DS to 3791. Fluid lost 6"; bailed
4 bbl. water per hour for two hrs.
No shows of oil. DSA 7-6-50 -
Pipe to be pulled and hole plugged.

The undersigned, Robert F. Walters, of Heathman Drilling Co., Inc. hereby certifies that the above is a true and correct log of the formations encountered in drilling the Young Well No. 1 as shown on the daily drilling reports.

HEATHMAN DRILLING CO., INC.

BY: Robert F. Walters

Subscribed and sworn to before me this 7th day of July 1950.

A. J. Harrison, Notary
Notary Public

My commission expires: June 29, 1952.

PLUGGING
FILE SEC 4 T 10 R 200
BOOK PAGE 14 LINE 41